

Name Robert Hayes

Service No. 151

Address 133 Worthen Road

Location Lot 68

Kind of Pipe

Size

Size of Main


~~XXXXXXXXXX~~ New Service W.D.# 8263Location *Comm 2-10-64*

Date	Material	Amount	Total	Date	Amount
8-19-60	Labor	13 08		10-24-63	200 00
	10% O.H.	1 31	14 39	2-10-64	33 53
	33' 6" Transite pipe @ .42		23 10		167 47
	1 11 $\frac{1}{2}$ " Bend		5 10		
	1 Hr. Trucking @ 3.00		3 00		
	<i>Bill When Connected</i>		45 59		
10/31/63	Labor	71 81			
	10% O.H.	7 18	78 99		
	30' 6" Transite Pipe @ .82		24 60		
	1 11 $\frac{1}{2}$ " Transite Elbows @ 2.35		4 70		
	1 11 $\frac{1}{2}$ " Transite Bend		4 09		
	1 Hr. Town Shovel @ 6.50		6 50		
	1 Hr. Trucking @ 3.00		3 00		
			167 47		

TOWN OF LEXINGTON — BOARD OF PUBLIC WORKS  
DATE \_\_\_\_\_

SEWER DIVISION

Sketch of Service Here

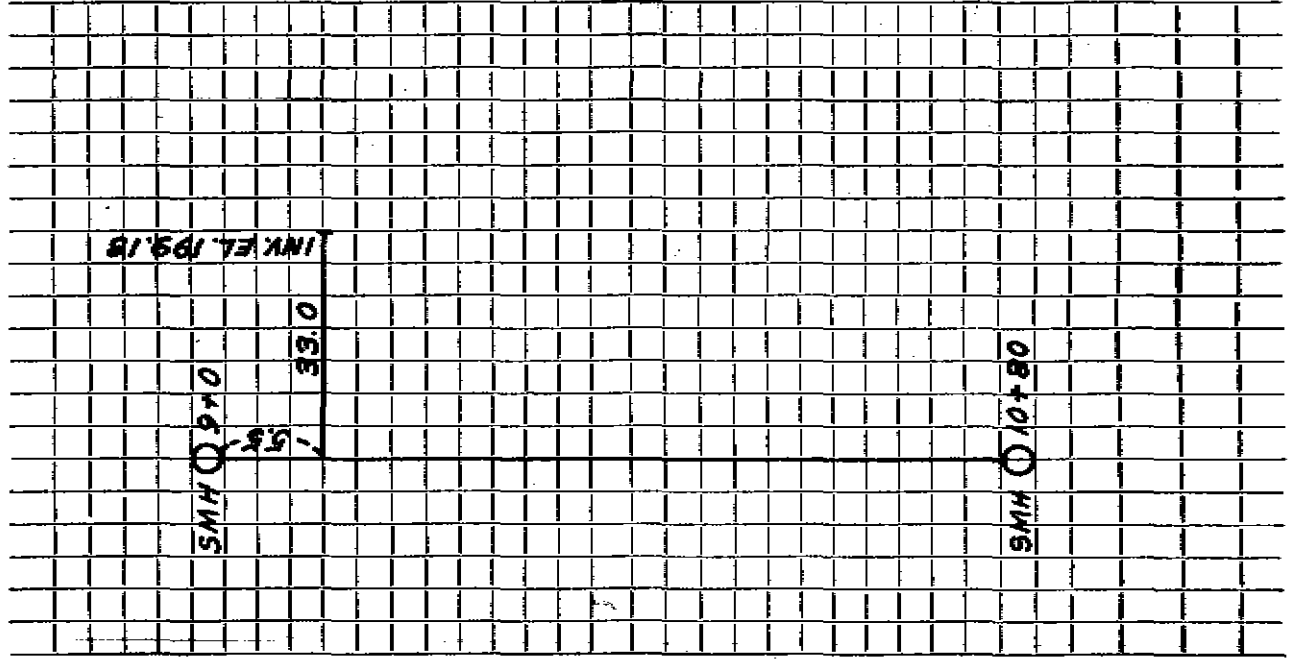

Connection made in \_\_\_\_\_ Street. Work completed \_\_\_\_\_

Remarks: \_\_\_\_\_