

Name John E. Lundquist

Service No. 196

Address 134 Worthen Road

Location Lot 45

Kind of Pipe

Size

Size of Main

Repair—Renewal—New Service

WO# 8333

Location

MAR 23 1964


| Date | Material | Amount | Total | Date | Amount |
|---------|----------------------------|--------|--------|----------|--------|
| 8-22-60 | Labor | 13 08 | | 11-21-63 | 125 00 |
| | 10% O.H. | 1 31 | 14 39 | 3-23-64 | 23 22 |
| | 30' 6" Transite pipe | | 21 00 | | 101 28 |
| | 1 Hr Trucking @3.00 | | 3 00 | | |
| | <i>Bill when connected</i> | | 38 39 | | |
| 12/6/63 | Labor | 18 07 | | | |
| | 10% Overhead | 1 81 | 19 88 | | |
| | 40' 6" Transite pipe @ 82 | | 32 80 | | |
| | 1 bag Cement | | 1 50 | | |
| | 1 22 1/2" Transite Bend | | 4 09 | | |
| | 1 Adapter | | 1 62 | | |
| | 1 hr. Trucking | | 3 00 | | |
| | | | 67 89 | | |
| | | | 101 28 | | |

DATE _____

TOWN OF LEXINGTON — BOARD OF PUBLIC WORKS

SEWER DIVISION

Sketch of Service Here

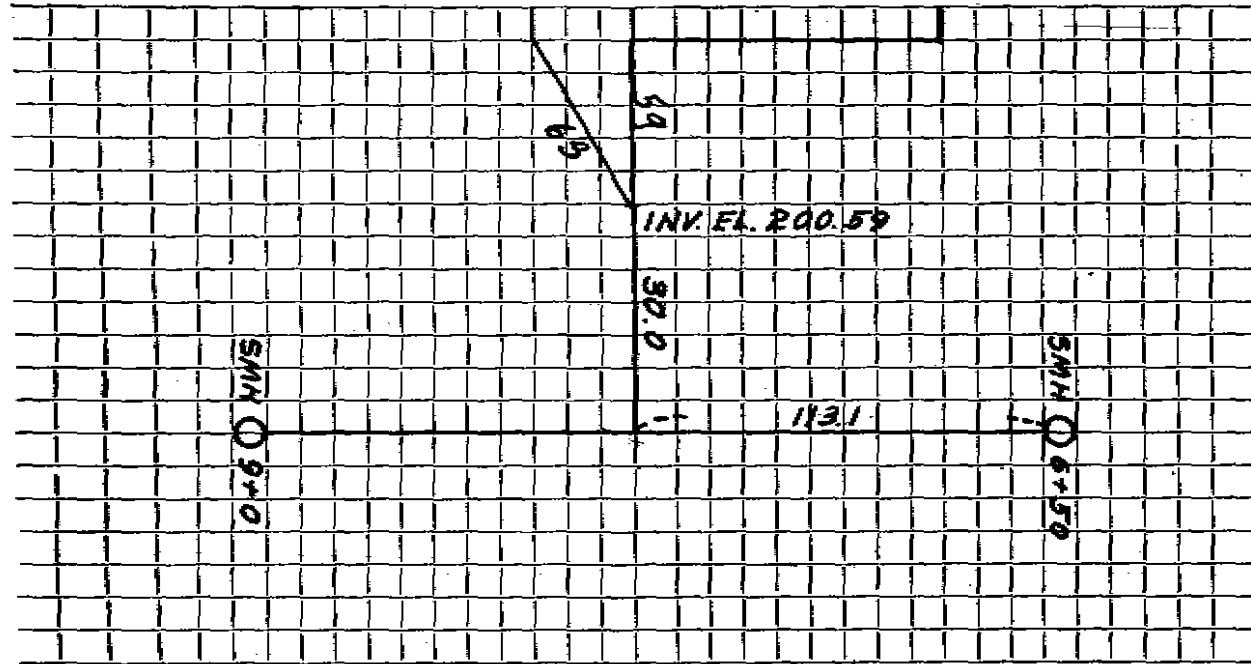

Connection made in Street. Work completed

Remarks:
.....
.....