

Name Colonial Contractor & Builders

Service No. 72

Address 135 Worthen Road

Location Lot 37

Kind of Pipe

Size

Size of Main

~~XXXXXXXXXX~~ New Service

W O - # 80.30

Location


Cam m. 10-28-63

Date	Material	Amount	Total	Date	Amount
8-22-60	Labor	13 08		6-14-63	200 00
	10% O.H.	1 31	14 39	10-28-63	16 73
	30' 6" Transite pipe		21 00		183 27
	1 11 1/2" Bend		5 10		
	1 Hr. Trucking @3.00		3 00		
	<i>Bill when connected</i>		43 49		
6-20-63	Labor	70 33			
	10% O.H.	7 03	77 36		
	40' 6" Transite pipe @.82		32 80		
	1 6" Duplex Adapter		1 62		
	6 Ton 1 1/2" Stone @1.50		9 00		
	2 Hrs. Town Shovel @6.50		13 00		
	2 Hrs. Trucking @3.00		6 00		
			183 27		

TOWN OF LEXINGTON — BOARD OF PUBLIC WORKS  
DATE \_\_\_\_\_

### SEWER DIVISION

Sketch of Service Here

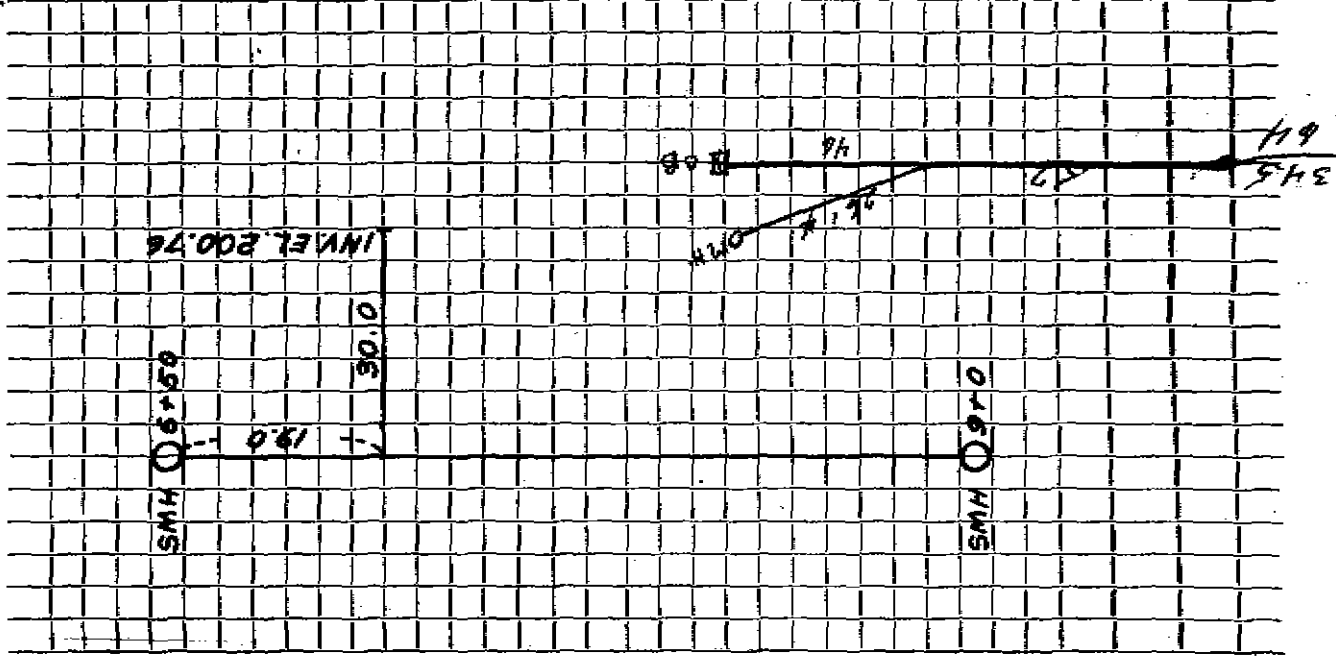

Work completed

Street

Connection made in

Remarks: