

Name John E. Lundquist

Address 137 Northern Road

Service No. 189

Location Lot 39

Kind of Pipe

New Service David Eagle - Permit #158

Size

Size of Main
DEC 28 1964

Locations

| Date | 1 | Material | Amount | Total | Date | Amount |
|----------|-----|------------------------|--------|--------|----------|---------------|
| 8-22-60 | 1 | Labor | 13 .08 | | 11-10-64 | <i>Amount</i> |
| | | 10% O.H. | 1 | 31 .14 | | |
| | | 40' 6" Transite pipe | | 28 .00 | | |
| | 1 | Hr. Trucking @3.00 | | 3 .00 | | |
| | | <i>Bld when burred</i> | | 45 .39 | | |
| 11-18-64 | 44' | 6" Transite pipe | | | | |

11-18-64 44' 6" Transite pipe

1

1

1

1


1

Remarks:

Connection made in

Street.

Work completed

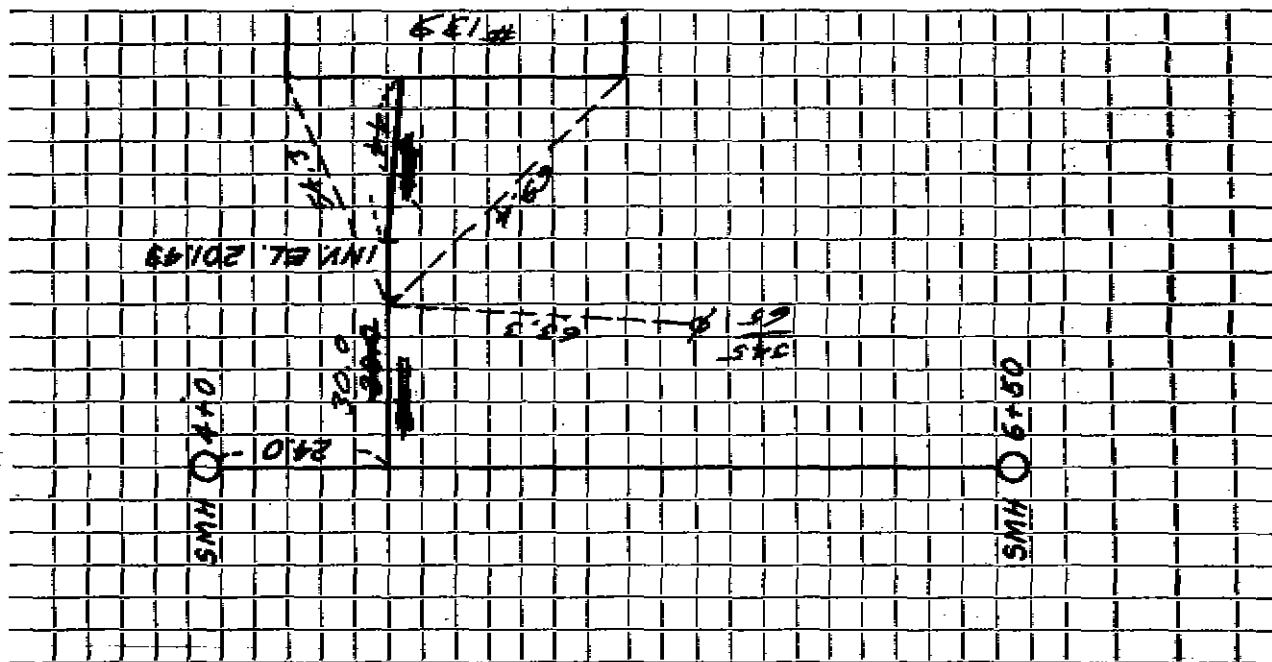

Sketch of Service Here

SEWER DIVISION

TOWN OF LEXINGTON — BOARD OF PUBLIC WORKS

DATE