




TOWN OF LEXINGTON — BOARD OF PUBLIC WORKS

SEWER DIVISION

DATE \_\_\_\_\_

Sketch of Service Here

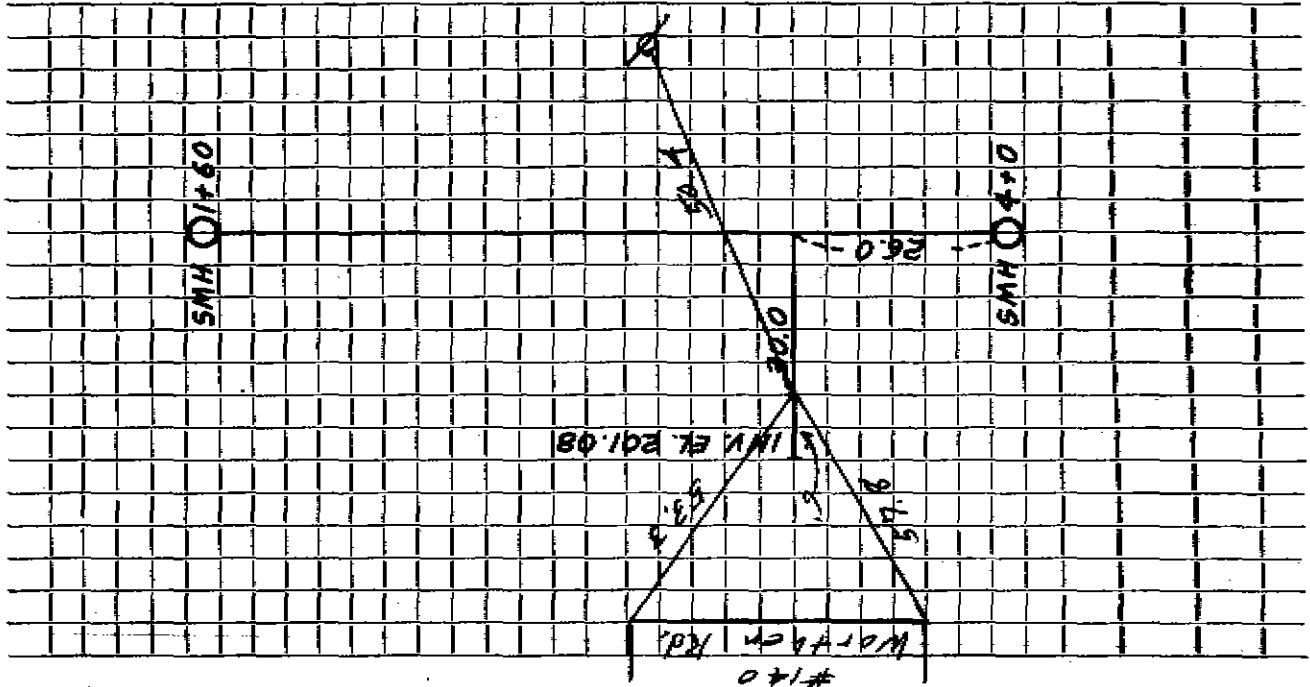

Street \_\_\_\_\_ Work completed \_\_\_\_\_

Connection made in \_\_\_\_\_

Remarks: \_\_\_\_\_