

Name Ciampa Bros.

Service No. 252

Address H/ Worthen Road

Location Lot 40

Kind of Pipe DeFalice Bros.

Size of Section

~~XXXXXXXXXX~~ - New Service Permit # A 156

Location MAR 14 1966


| Date | Material | Amount | Total | Date | Amount |
|----------------------|----------------------|--------|-------|---------|--------|
| 8-22-60 | Labor | 13 08 | | 12-1-65 | |
| | 10% O.E. | 1 31 | 14 39 | Deposit | 38 39 |
| 30' 6" Transite pipe | | | 21 00 | | |
| 1 Hr. Trucking | 63.00 | | 3 00 | | |
| Nov '65 | 47' 6" Transite Pipe | | 38 39 | | |
| | | | | | |
| | | | | | |
TOWN OF LEXINGTON — BOARD OF PUBLIC WORKS

SEWER DIVISION

DATE _____

Sketch of Service Here

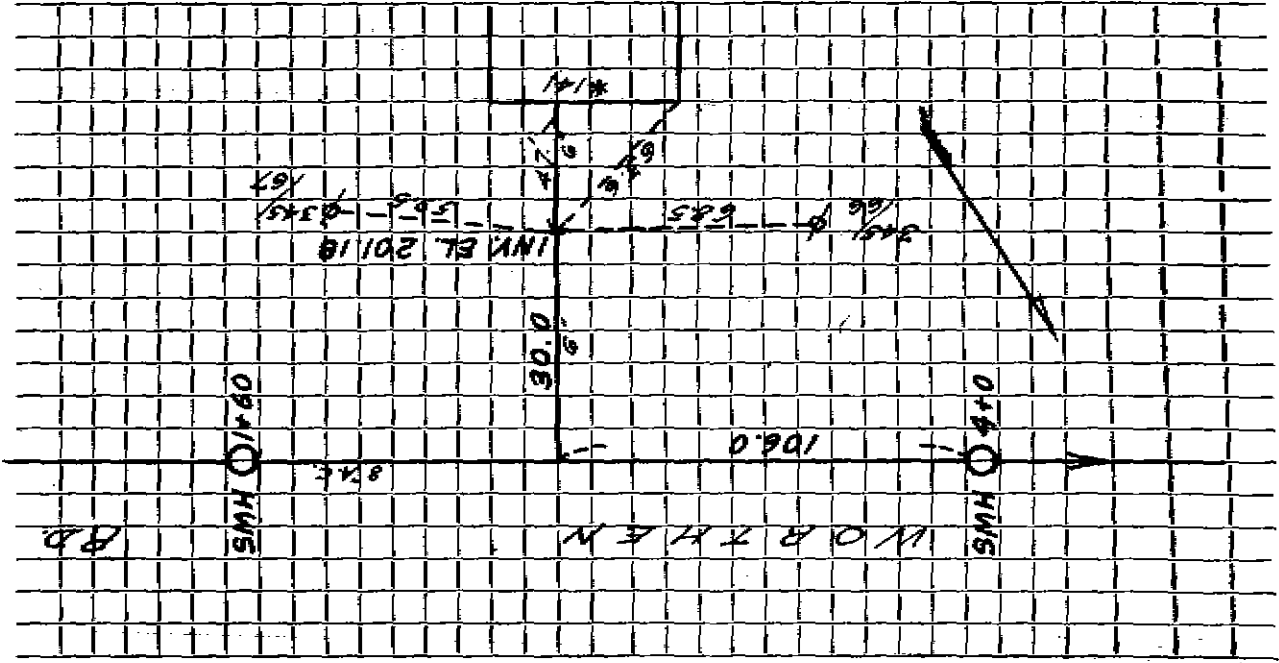

Connection made in _____

Street _____

Work completed _____

Remarks: _____