

Name Colonial Contractors & Builders

Service No. 194

Address 142 Worthen Road

Location Lot 41

Kind of Pipe

Size

Size of Main

Refrigeration - New Service W.O. #7001

Location Comm. 1-26-65

Date	Material	Amount	Total	Date	Amount
8-22-60	Labor	13 08		11-30-61	300 00
	10% O.H.	1 31	14 39	2-26-62	181 50
	30' 6" Transite pipe		21 00		118 22
	1 hr. Trucking @3.00		3 00		
	<u>NOT BILLED</u>		38 39		
12-15-61	Labor	60 58			
	10% O.H.	6 06	66 64		
	43' 6" Transite pipe @.78		33 54		
	1 11" Transite Elbow		2 24		
	2 hrs. Tom Shovel @6.50		13 00		
	1 hr. Trucking @3.00		3 00		
			118 42		


Deposit  
Returned

TOWN OF LEXINGTON — BOARD OF PUBLIC WORKS

SEWER DIVISION

DATE \_\_\_\_\_

Sketch of Service Here

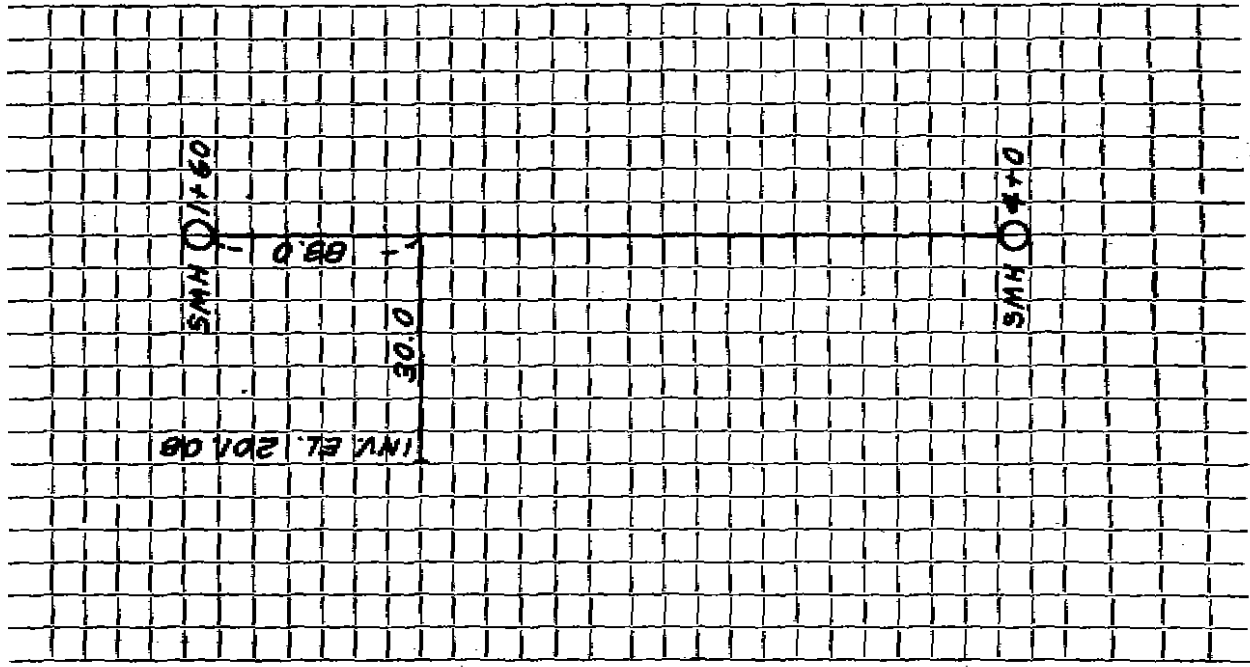

Connection made in \_\_\_\_\_ Street. Work completed \_\_\_\_\_

Remarks: \_\_\_\_\_  
\_\_\_\_\_  
\_\_\_\_\_