

Name DeFlice Brothers

Service No.

Address 21 Worthen Road

Location

Kind of Pipe

Size

Size of Main

Repair—Renewal—New Service DeFlice #1382


Location

Date		Material	Amount	Total	Date	Amount
6-19-70	77'	6" Transite Pipe				
	10'	4" Cast Iron Pipe				

DATE _____

TOWN OF LEXINGTON — BOARD OF PUBLIC WORKS
SEWER DIVISION

Sketch of Service Here

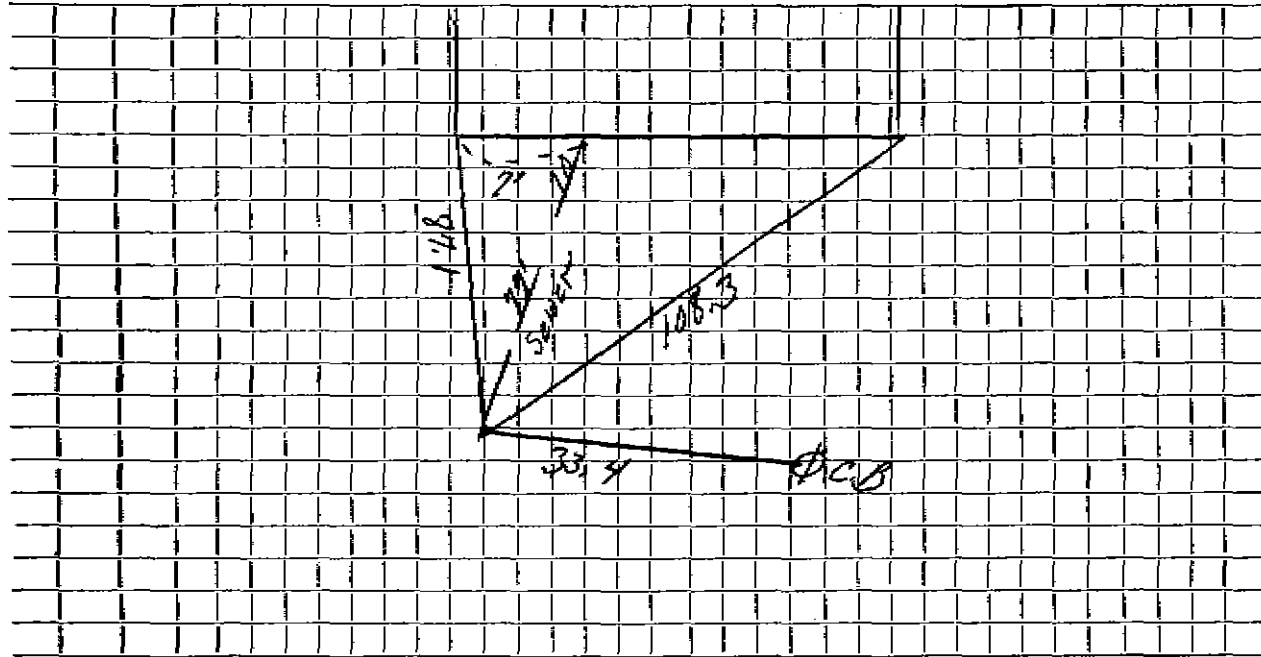

Connection made in Street. Work completed

Remarks:
.....
.....