

Name Duffy Bros.

Service No.

Address 229 Worthen Road

Location *Lot L.C. 183*

Kind of Pipe

Size

Size of Main

Repair—Renewal—New Service Bonanno #1390

Location


Date	Material	Amount	Total	Date	Amount
6-23-69	62' 6" Transite pipe				
	10' 4" Cast Iron pipe				

DATE _____

TOWN OF LEXINGTON — BOARD OF PUBLIC WORKS

SEWER DIVISION

Sketch of Service Here

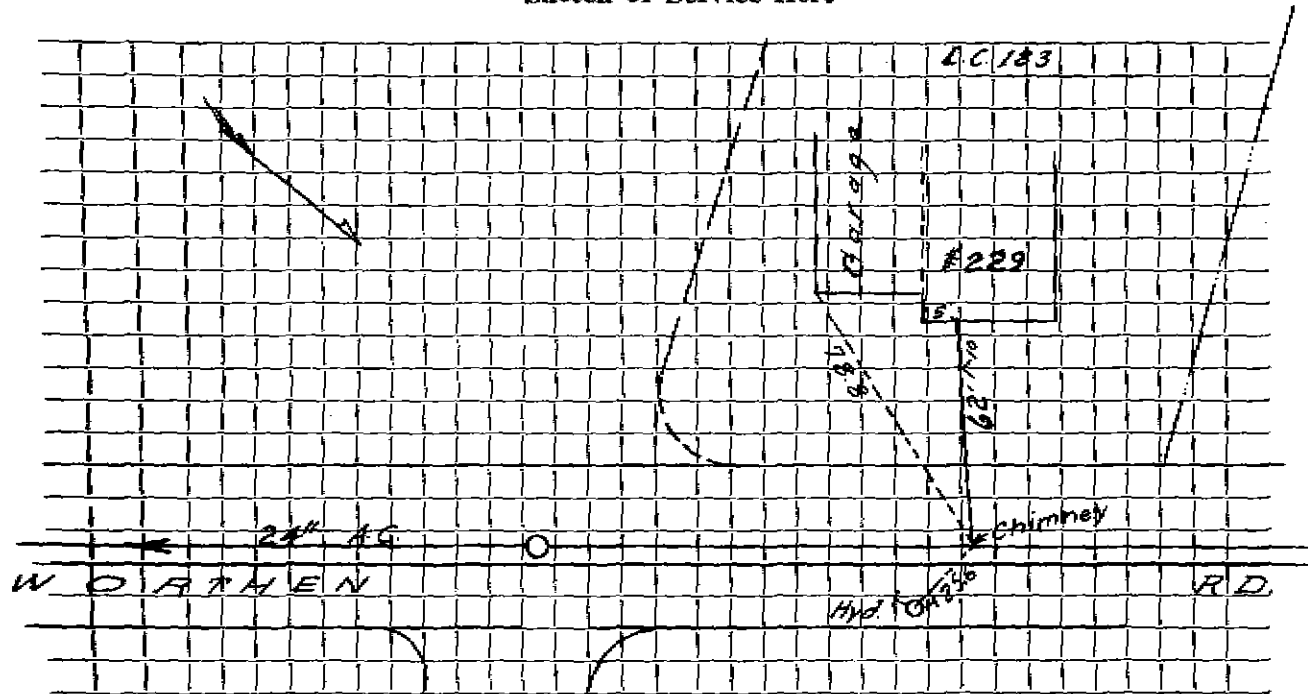

Connection made in _____ Street. Work completed _____

Remarks: _____

GOFFE
RD.