

Name Nicholas Bonanno

Service No.

Address 232 Worthen Road

Lot 212

Location

Kind of Pipe

Size

Size of Main

Repair—Renewal—New Service

Bonanno #983  
Bonanno #588

Location

Date

Material

Amount

Total

Date

Amount

6-10-67 35' 6" Transite pipe

4-2-68 57' 6" Transite pipe


10' 4" Cast Iron pipe

DATE \_\_\_\_\_

# TOWN OF LEXINGTON — BOARD OF PUBLIC WORKS

## SEWER DIVISION

Sketch of Service Here

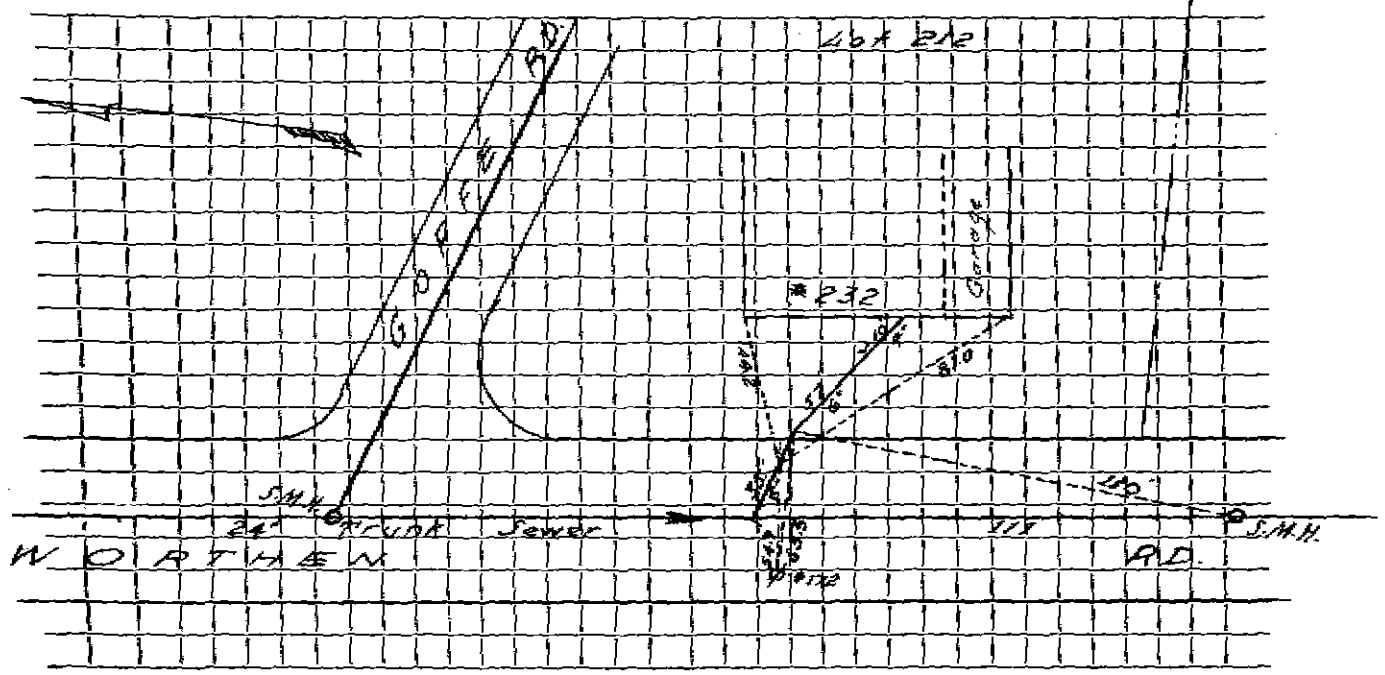

Connection made in ..... Street. Work completed .....

Remarks: .....  
.....  
.....