

Name Duffy Bros.

Service No.

Address 238 Worthen Road

Location Lot #209

Kind of Pipe

Size

Size of Main

Repair—Renewal—New Service

Bonanno - Permit #594 & 713

Location


Date		Material	Amount	Total	Date	Amount
6/13/67	37'	6" Transite				
7-21-67	26'	6" Transite pipe				
	10'	4" Cast Iron pipe				

TOWN OF LEXINGTON — BOARD OF PUBLIC WORKS

SEWER DIVISION

DATE \_\_\_\_\_

Sketch of Service Here

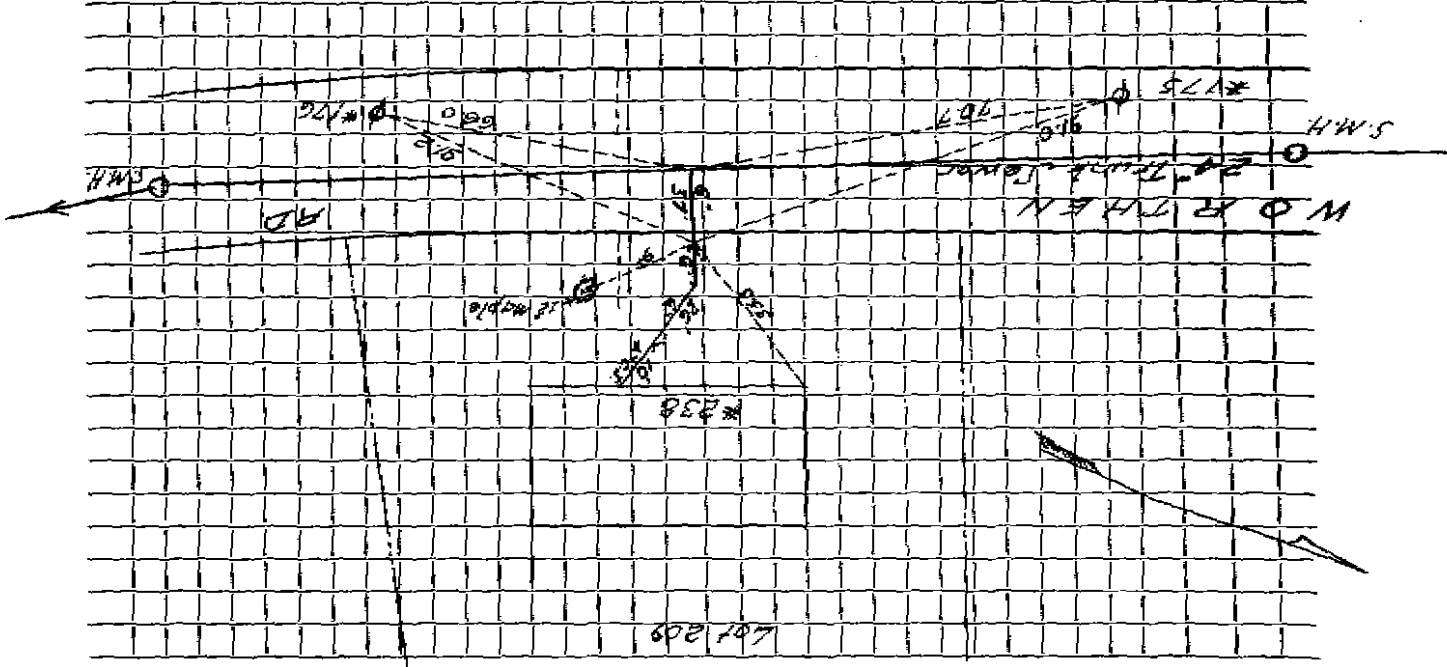

Street. Work completed

Connection made in

Remarks: