

Name Duffy Brothers

Service No.

Address 211 Worthen Road

Location Lot #177

Kind of Pipe

Size

Size of Main

Repair—Renewal—New Service

Bonanno #894
Bonanno - Permit #597

Location


| Date | Material | Amount | Total | Date | Amount |
|--------|-----------------------|--------|-------|------|--------|
| 6/5/67 | 42' 6" Transite | | | | |
| 2-1-68 | 55' 6" Transite pipe | | | | |
| | 10' 4" Cast Iron pipe | | | | |
| | | | | | |
| | | | | | |
DATE _____

TOWN OF LEXINGTON — BOARD OF PUBLIC WORKS

SEWER DIVISION

Sketch of Service Here

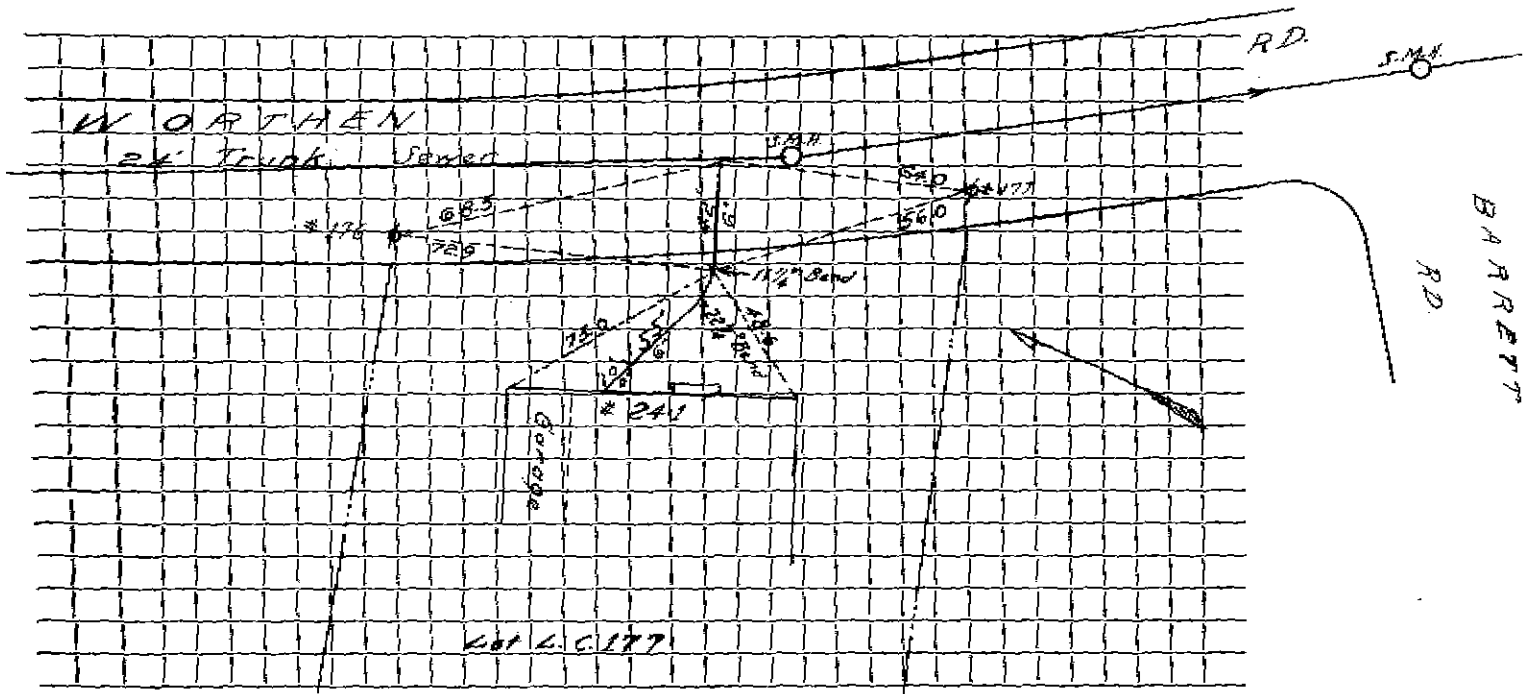

Connection made in Street. Work completed

Remarks:

.....

.....