

Name

Service No.

Address

21 1/2 Worthen Road

Location

Lot #206

Kind of Pipe

Size

Size of Main

Repair—Renewal—New Service

Bonanno - Permit #600

Location

Date

Material

Amount

Total

Date

Amount

6/7/67

63'


6" Transite

10' Cast Iron

DATE _____

TOWN OF LEXINGTON — BOARD OF PUBLIC WORKS
SEWER DIVISION

Sketch of Service Here

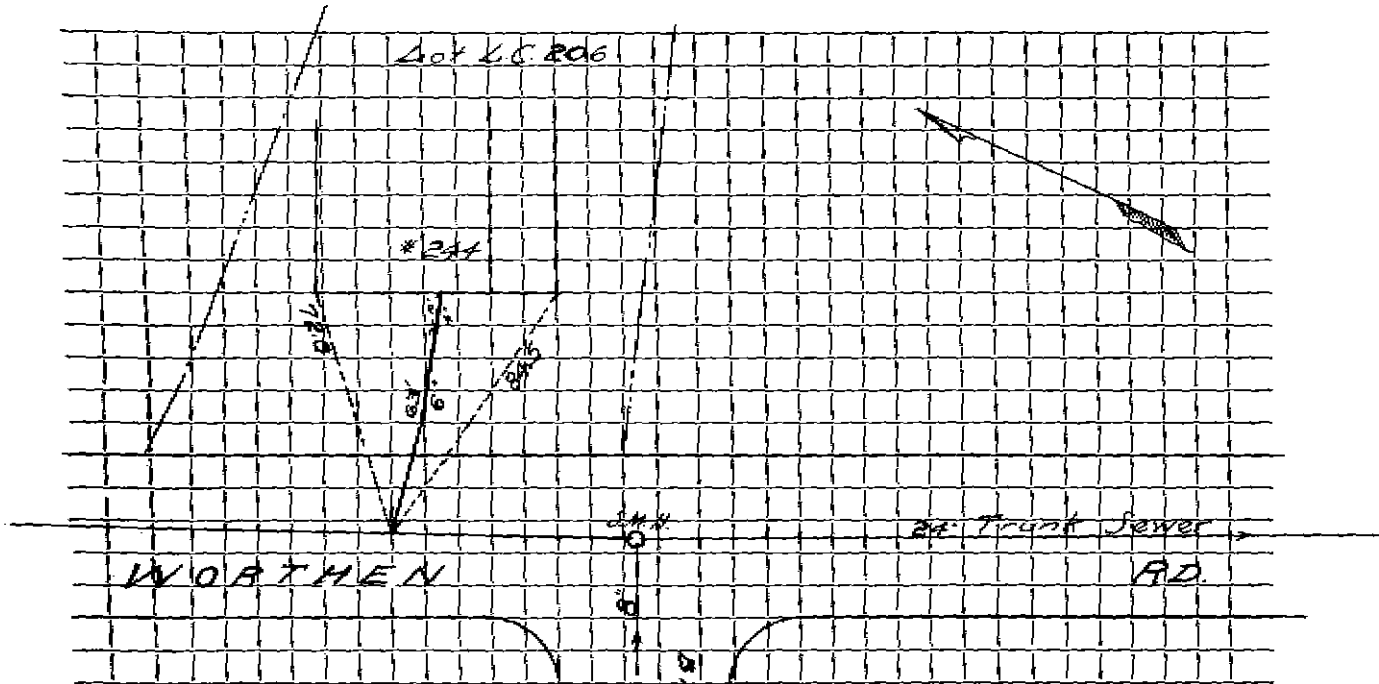

Connection made in Street. Work completed

Remarks:

.....

.....