

Name

Service No.

Address

215 Worthen Road

Location

Lot #175

Kind of Pipe

Size

Size of Main

Repair—Renewal—New Service

Bonanno - Permit #601

Location

Date

Material

Amount

Total

Date

Amount

6/1/67 59.6 6" Transite


10' 4" Cast Iron

DATE _____

TOWN OF LEXINGTON — BOARD OF PUBLIC WORKS

SEWER DIVISION

Sketch of Service Here

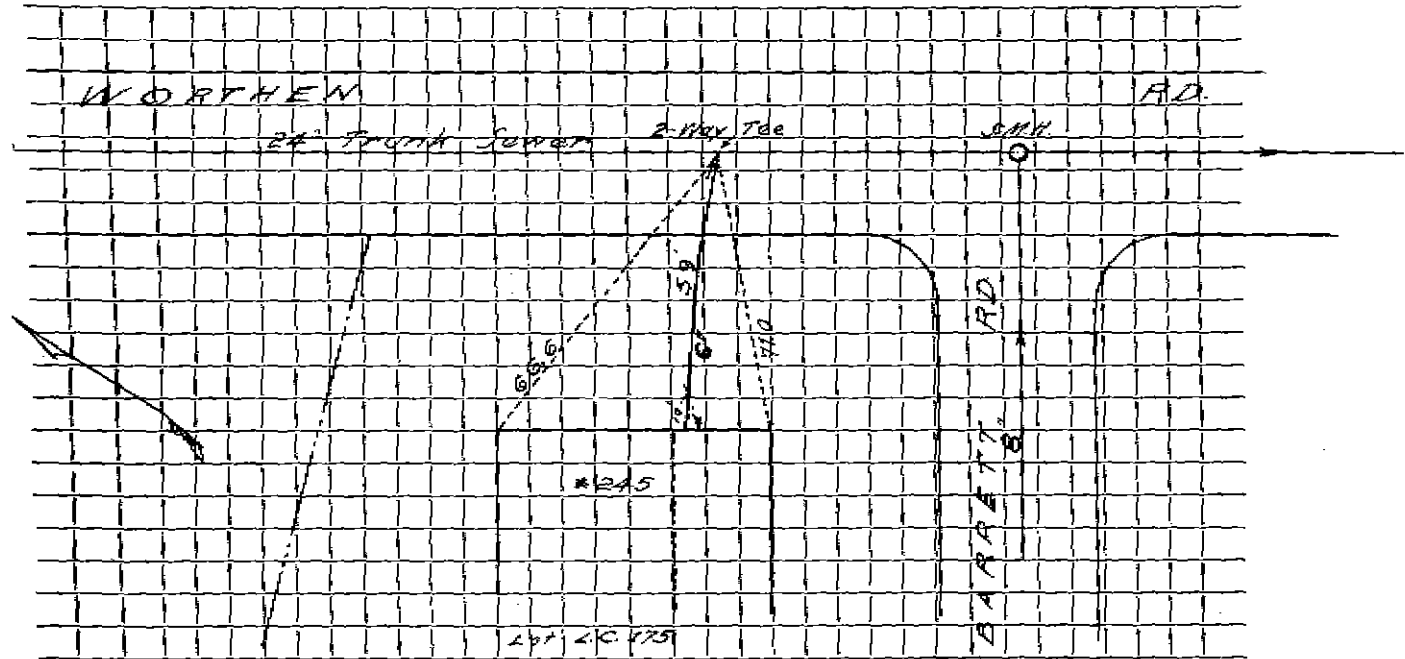

Connection made in Street. Work completed

Remarks:

.....

.....