

Name Duff Brothers

Address 242 Northern Road

Lot 144 Sta 7 + 40

Location

Service No.


Kind of Pipe	Size	Size of Main		Amount
		Date	Location	
Repair—Reoval—New Service John Flannery Permit #329				
Date	Material	Amount	Total	Date
6-28-65	39' 6" Transite pipe			

Remarks:

Connection made in

Street

Work completed

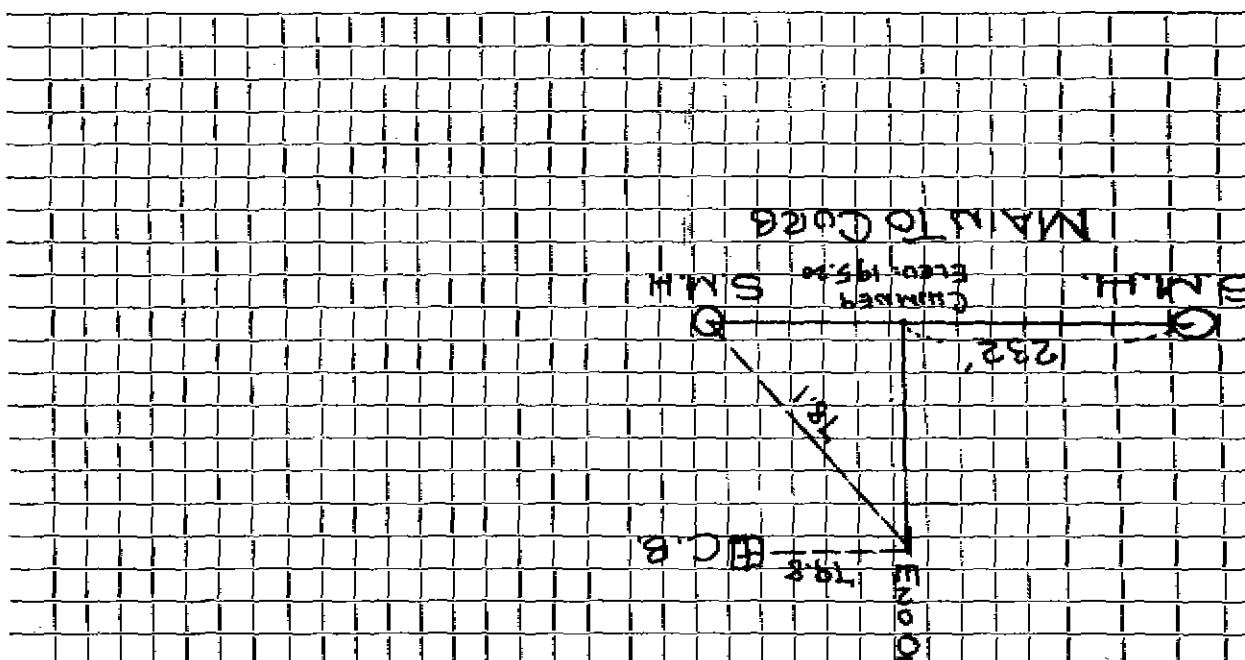

MAIN TO CDA 6

SMH
Cylinder 19570
Cylinder

232

4

4

Sketch of Service Here

SEWER

1957 EIC 8

SEWER DIVISION

TOWN OF LEXINGTON — BOARD OF PUBLIC WORKS

DATE