




TOWN OF LEXINGTON — BOARD OF PUBLIC WORKS

SEWER DIVISION

DATE \_\_\_\_\_

Sketch of Service Here

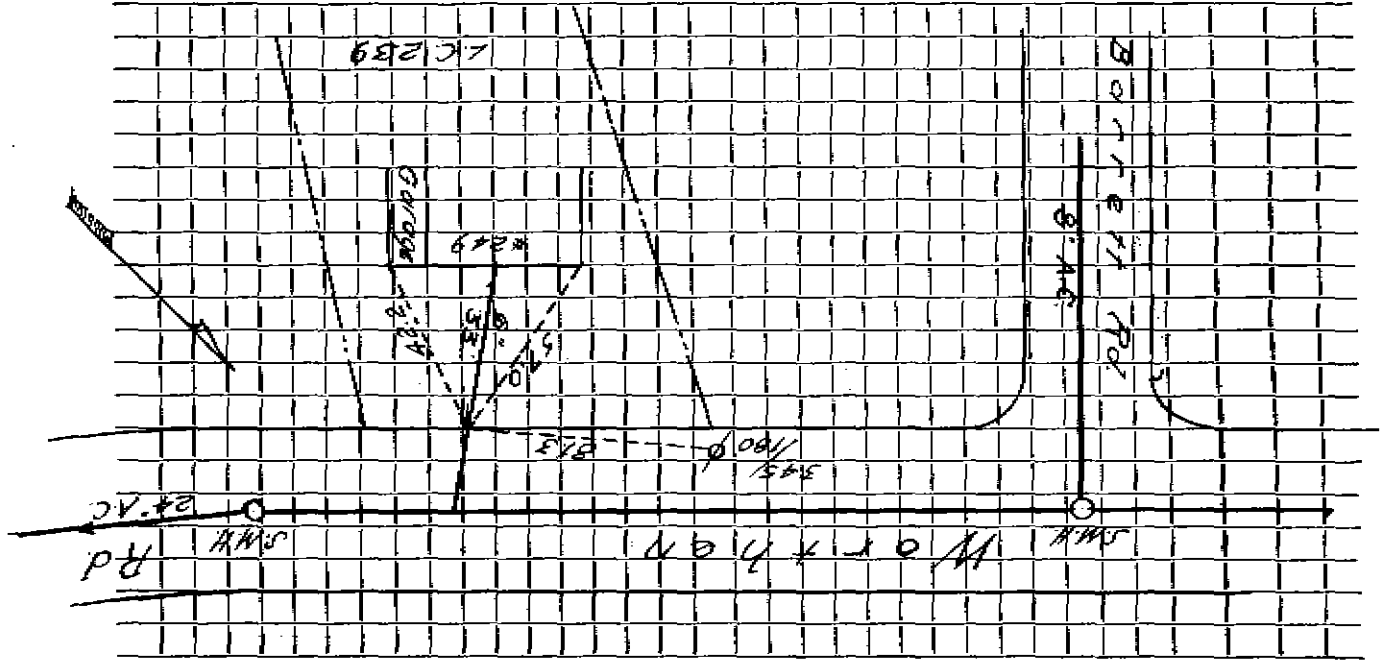

Connection made in \_\_\_\_\_ Street. Work completed \_\_\_\_\_

Remarks: \_\_\_\_\_

Name **Duffy Brothers**

Service No.

Address **249 Northen Road**

Lot **143** Sta **6+30**

Location

Kind of Pipe

Size

Size of Main

Repair—Renewal—New Service

John Flannery Permit #327

Location

Date

Material

Amount

Total

Date

Amount


6-28-65 12' 6" Transite pipe

DATE \_\_\_\_\_

TOWN OF LEXINGTON — BOARD OF PUBLIC WORKS

SEWER DIVISION

Sketch of Service Here

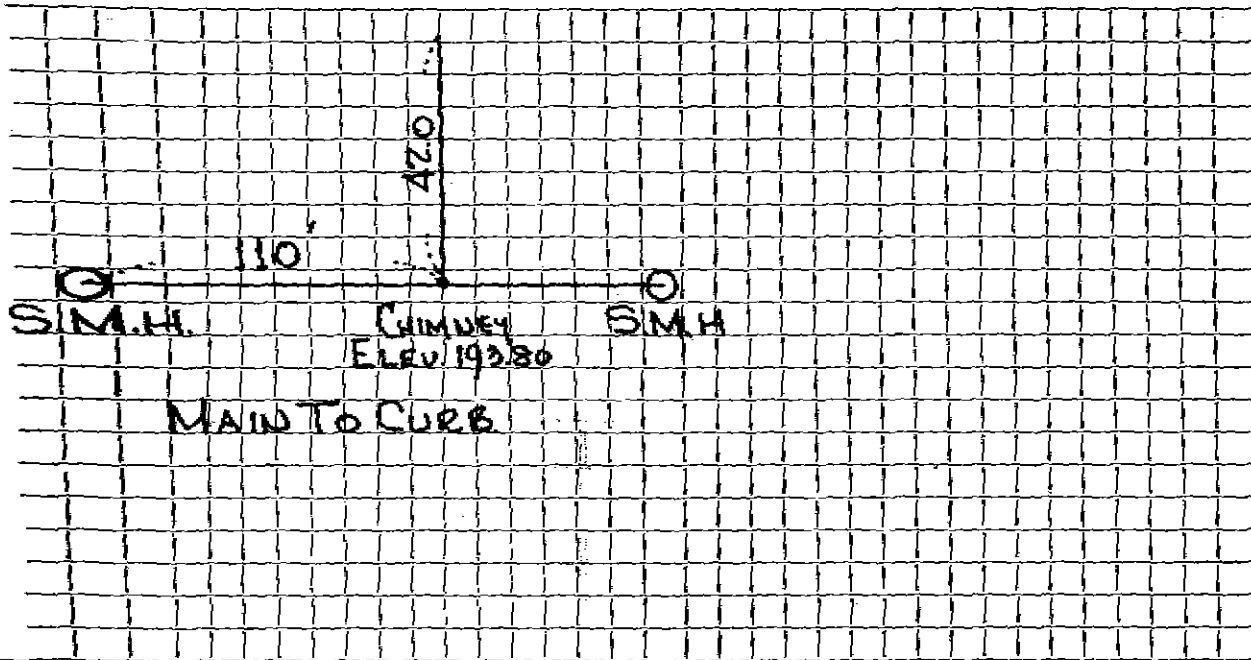

Connection made in ..... Street. Work completed .....

Remarks: .....

.....

.....