

Name **Duffy Brothers**

Service No.

Address **252 Worthen Road**

Lot **203** Ste **4+25**

Location

Kind of Pipe

Size

Size of Main

Repair—Renewal—New Service **John Flannery Permit #324**

Location

Date	Material	Amount	Total	Date	Amount
6-28-65	33' 6" Transite pipe				
11-7-65	26' 6" Transite pipe				
				DEC 13, 1996	
				Repair MADE AT	
				chimney	
				L-45° Bend	
				6' of 6" PVC	
				6x6 PVC to PVC	
				6x6 PVC to AC	


1996

DATE _____

TOWN OF LEXINGTON — BOARD OF PUBLIC WORKS

SEWER DIVISION

Sketch of Service Here

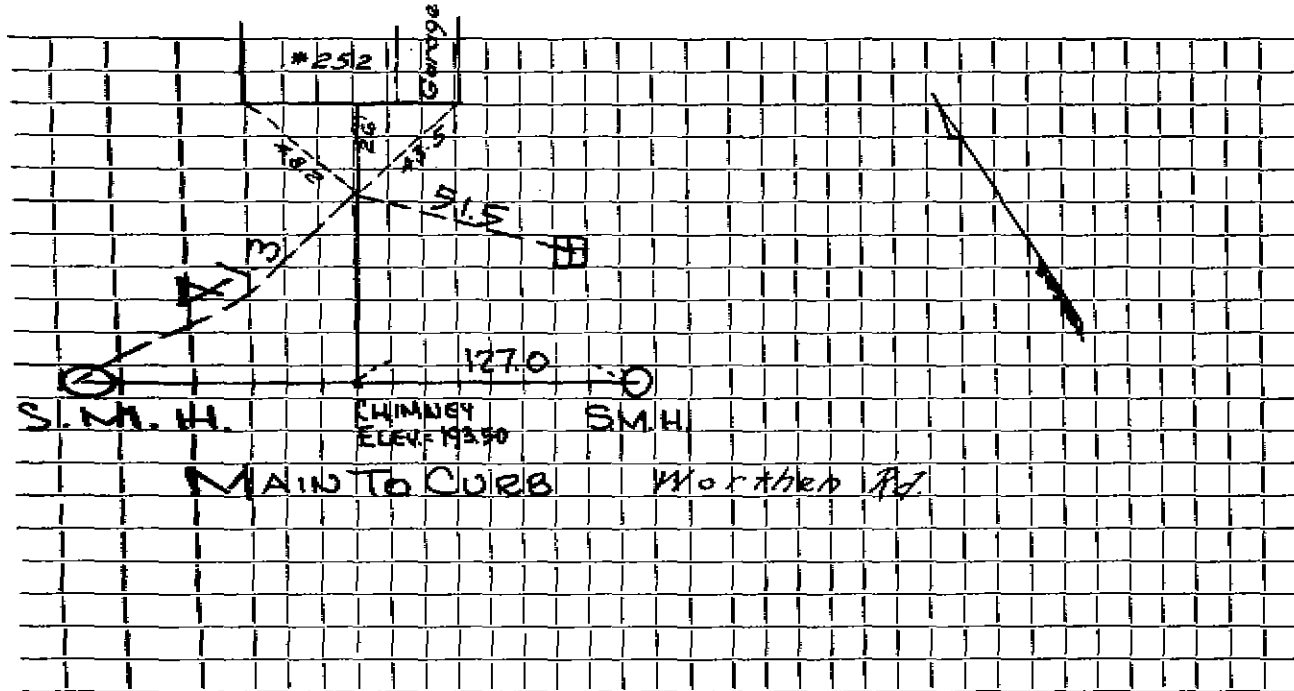

Connection made in Street. Work completed

Remarks:
.....
.....