

Name **Duffy Brothers**

Service No.

Address **254 Worthen Road**

Location

Kind of Pipe **Permit #9**

Size

Size of Main

~~XXXXXXXXXX~~ **New Service John Flannery**

Location


Date		Material	Amount		Total	Date		Amount	
9-28-65	31'	6" Transite pipe							

TOWN OF LEXINGTON — BOARD OF PUBLIC WORKS

SEWER DIVISION

DATE _____

Sketch of Service Here

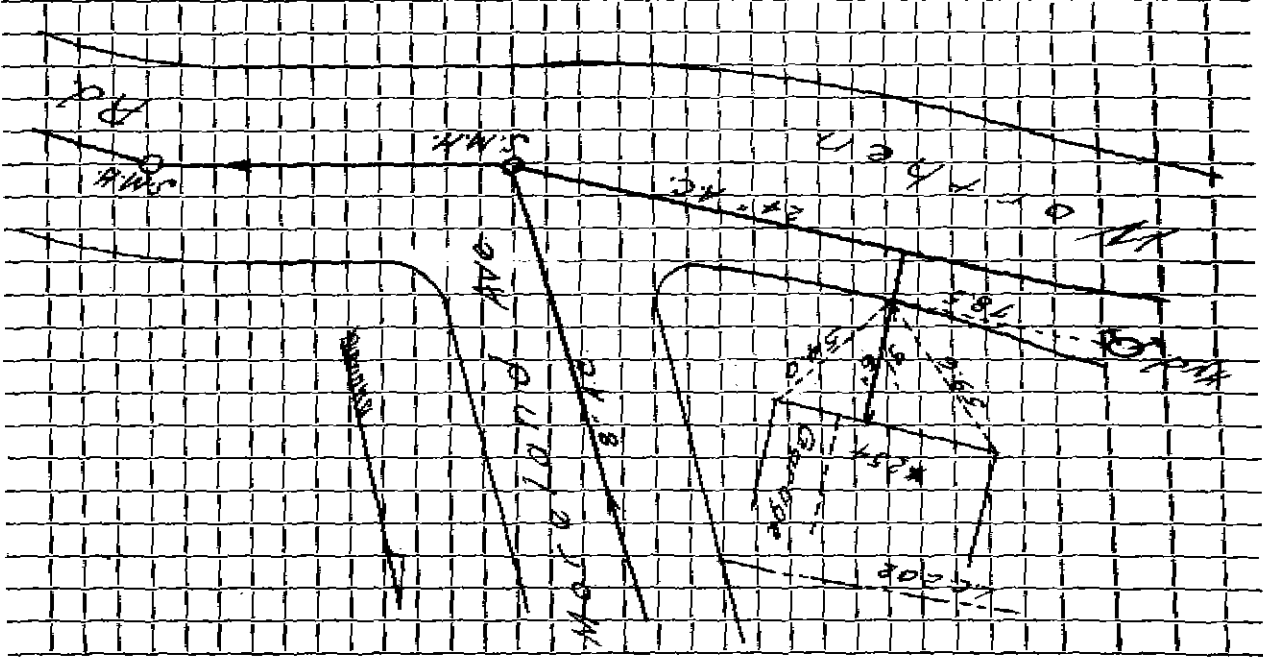

Work completed

Street


Connection made in

Remarks:

DATE _____

TOWN OF LEXINGTON — BOARD OF PUBLIC WORKS
SEWER DIVISION

Sketch of Service Here

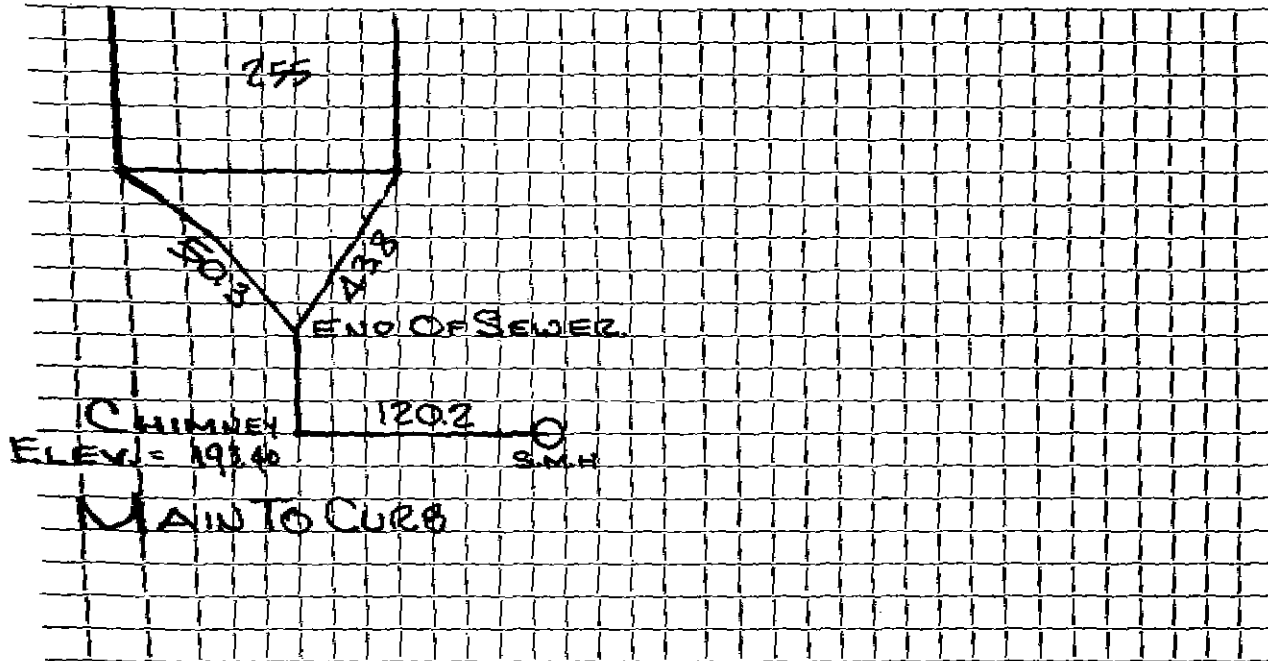

Connection made in Street. Work completed

Remarks:
.....
.....