




**SEWER DIVISION**

Sketch of Service Here

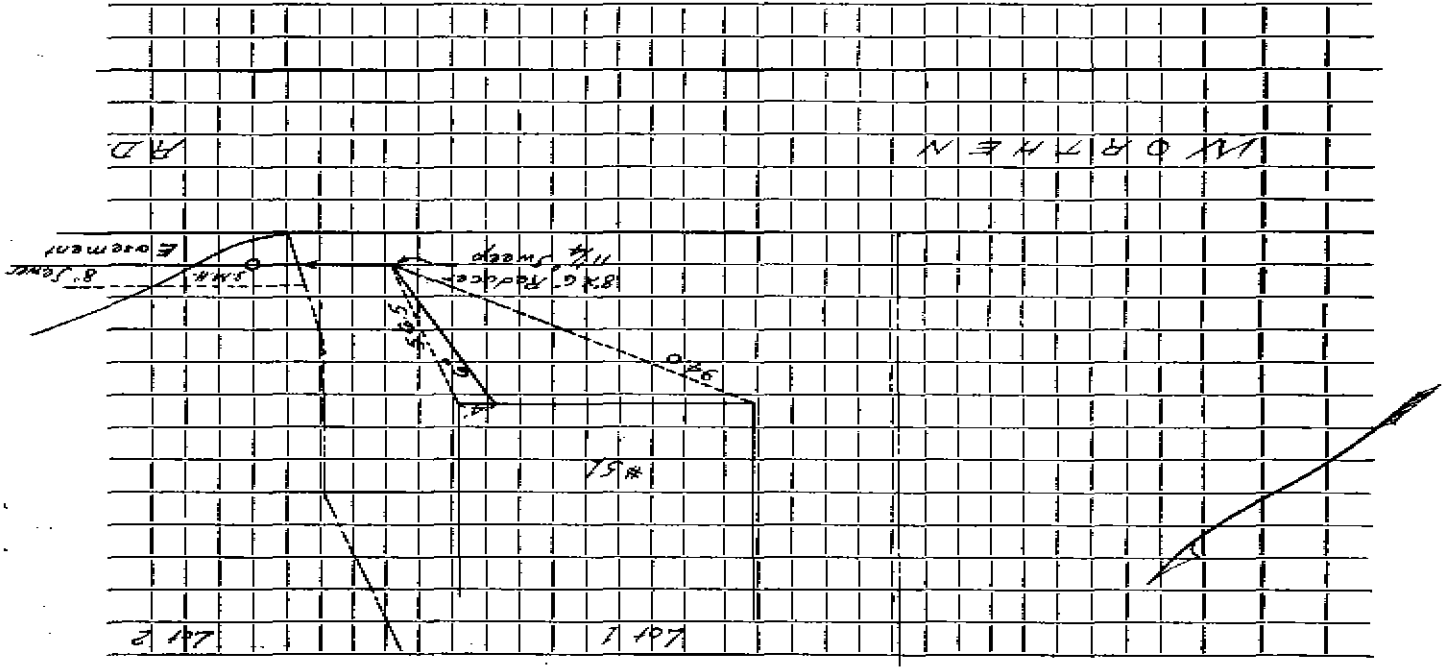

Connection made in \_\_\_\_\_  
 Street, \_\_\_\_\_  
 Work completed \_\_\_\_\_  
 Remarks: \_\_\_\_\_