


DATE JULY 1995

TOWN OF LEXINGTON — BOARD OF PUBLIC WORKS
SEWER DIVISION

Sketch of Service Here

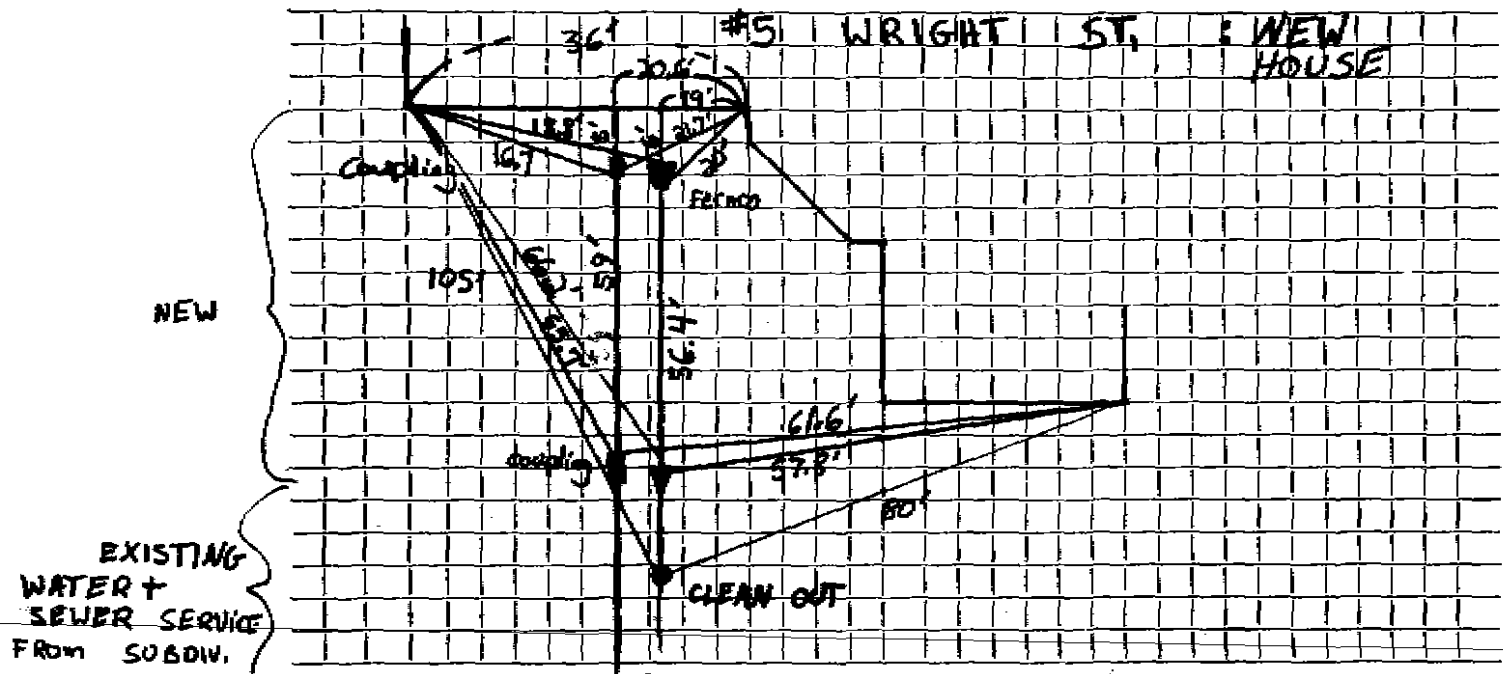

Connection made in Street. Work completed

Remarks: S & W INSP. N.B. # 95-1, P 4

PGH / J.M. INSP