

Name M. WEISMAN (INSP) ; McLAUGHLIN (CONTRACTOR) Service No. _____
 Address 78 WYMAN RD

Location _____

Kind of Pipe

Size

Size of Main

Repair Renewal New Service


Location

Date		Material	Amount	Total	Date	Amount
1/4/19	.	6" SDR	~40'			
"	.	6" CLEAN OUT · 6" SDR DISK · 6" TEE W/4" · 6" PVC CAP	(2)			
"	.	11" BEND				
		6" CLEAN OUT				

DATE 1/4/2019

TOWN OF LEXINGTON — BOARD OF PUBLIC WORKS
SEWER DIVISION

Sketch of Service Here

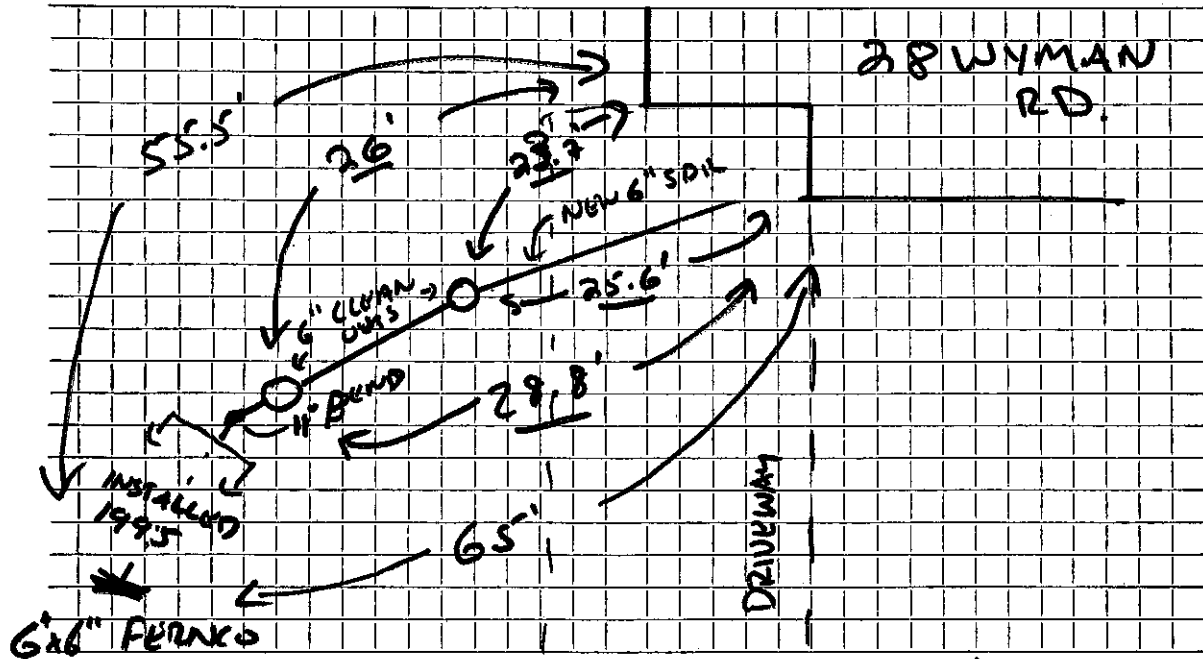

Connection made in WYMAN Street. Work completed MCLAUGHLIN
Remarks: REPAIR INCLUDES 2, 6\" CLEAN OUTS, BEND, AND NEW
6\" SDR PIPE FROM CLEAN OUTS TO HOUSE. CLEAN OUTS
SLEEP TOWARD) EACH OTHER TO ENABLE CLEANING UP UNTIL
LINE.