


DATE _____

TOWN OF LEXINGTON — BOARD OF PUBLIC WORKS
SEWER DIVISION

Sketch of Service Here

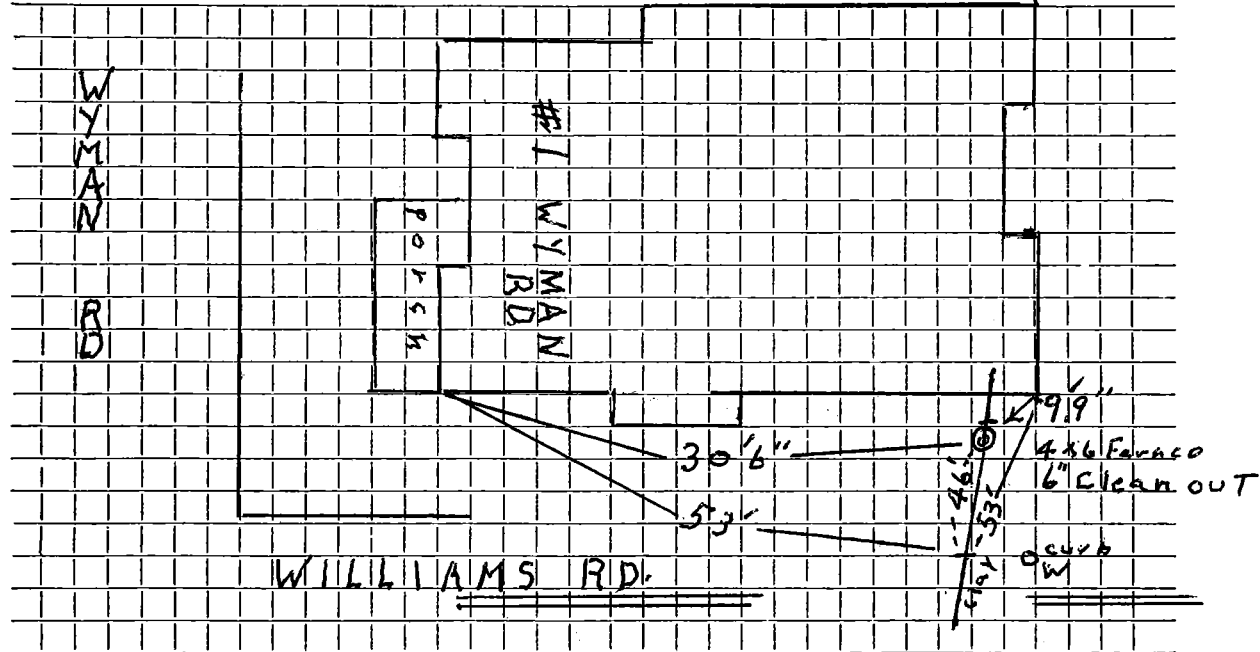

Connection made in Williams Rd. Street. Work completed 4/14/11

Remarks: TIPS are off foundation corners

.....
.....