




TOWN OF LEXINGTON — BOARD OF PUBLIC WORKS

SEWER DIVISION

DATE \_\_\_\_\_

Sketch of Service Here

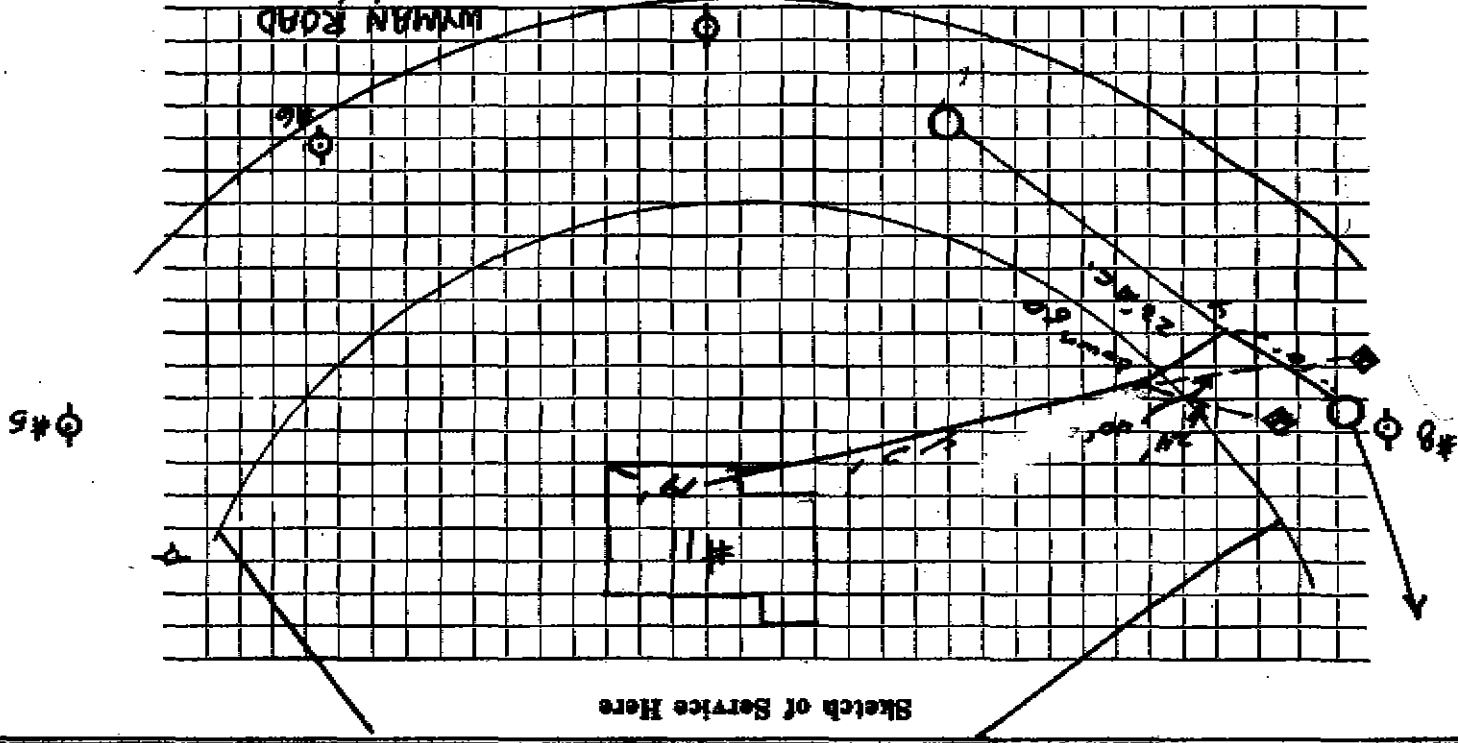

11/1/24

Work completed

Street

W. Wyman Rd

Connection made in

Remarks: