

Name

Address 16 WYMAN RD.

Location

Kind of Pipe A.C. Size 6" Size of Main 8"

Repair—Renewal—New Service Location


Date	Material	Amount	Total	Date	Amount
10/2/74	21' A.C.	18.00	1168.00		

DATE _____

TOWN OF LEXINGTON — BOARD OF PUBLIC WORKS

SEWER DIVISION

Sketch of Service Here

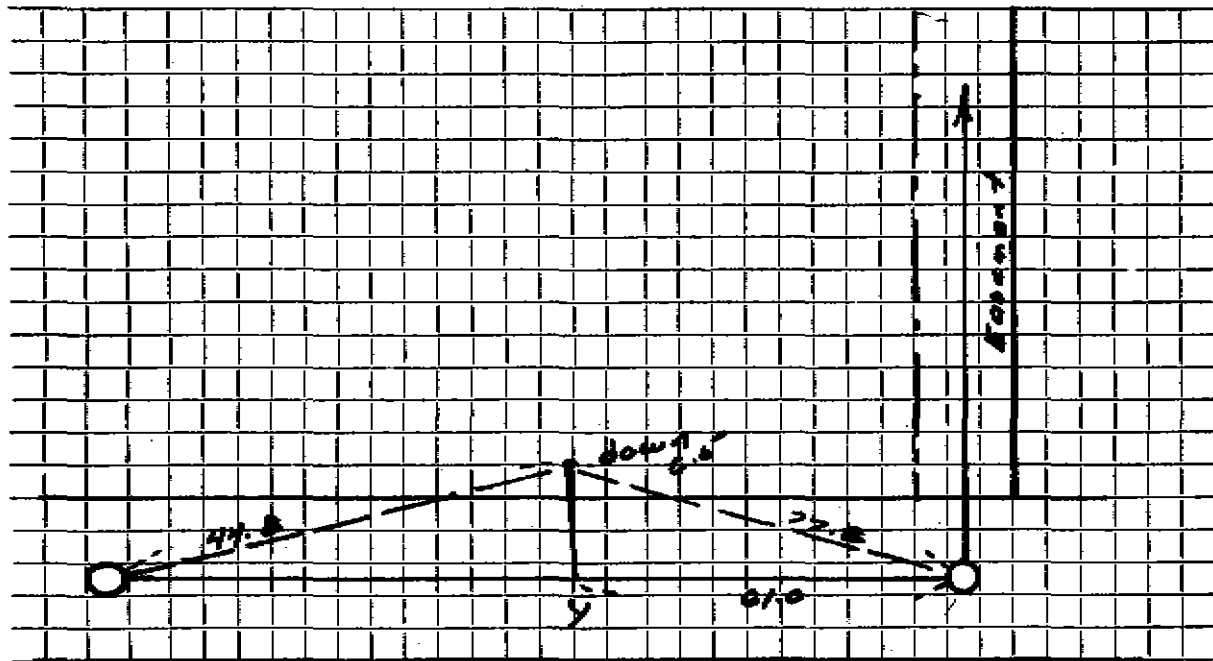

Connection made in Street. Work completed

Remarks:

.....

.....