




TOWN OF LEXINGTON — BOARD OF PUBLIC WORKS

SEWER DIVISION

Sketch of Service Here

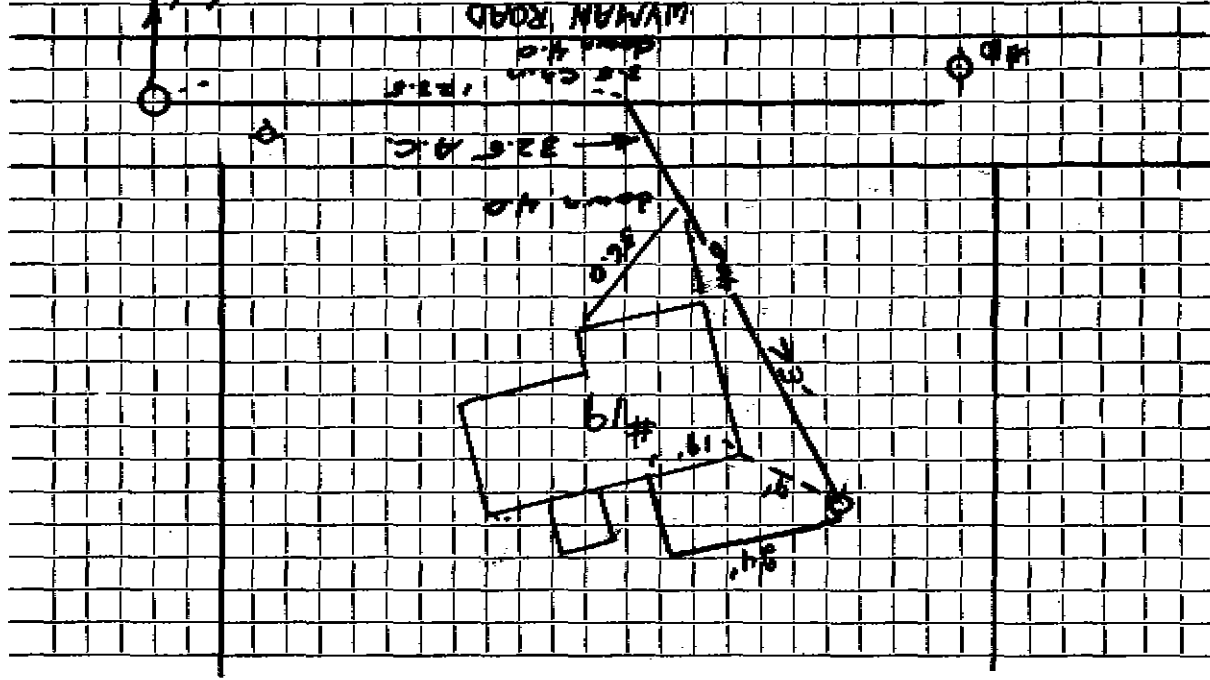

Work completed

Street

Rd. *W. Wymore*

Connection made in

Remarks:

*9/4/24*