

Name M.P. Eacock

Service No. 101

Address #20 Wymen Road

Location

Kind of Pipe

A.C.

Size

6"

Size of Main

8"

Repair—Renewal—New Service

Waiver #23549

Location

OCT 25 1976


Date	Material	Amount	Total	Date	Amount
9/4/74	20.0 A.C.	98.00	1160.00	10/29/74	Deposit
					162.00

TOWN OF LEXINGTON — BOARD OF PUBLIC WORKS

SEWER DIVISION

DATE

Sketch of Service Here

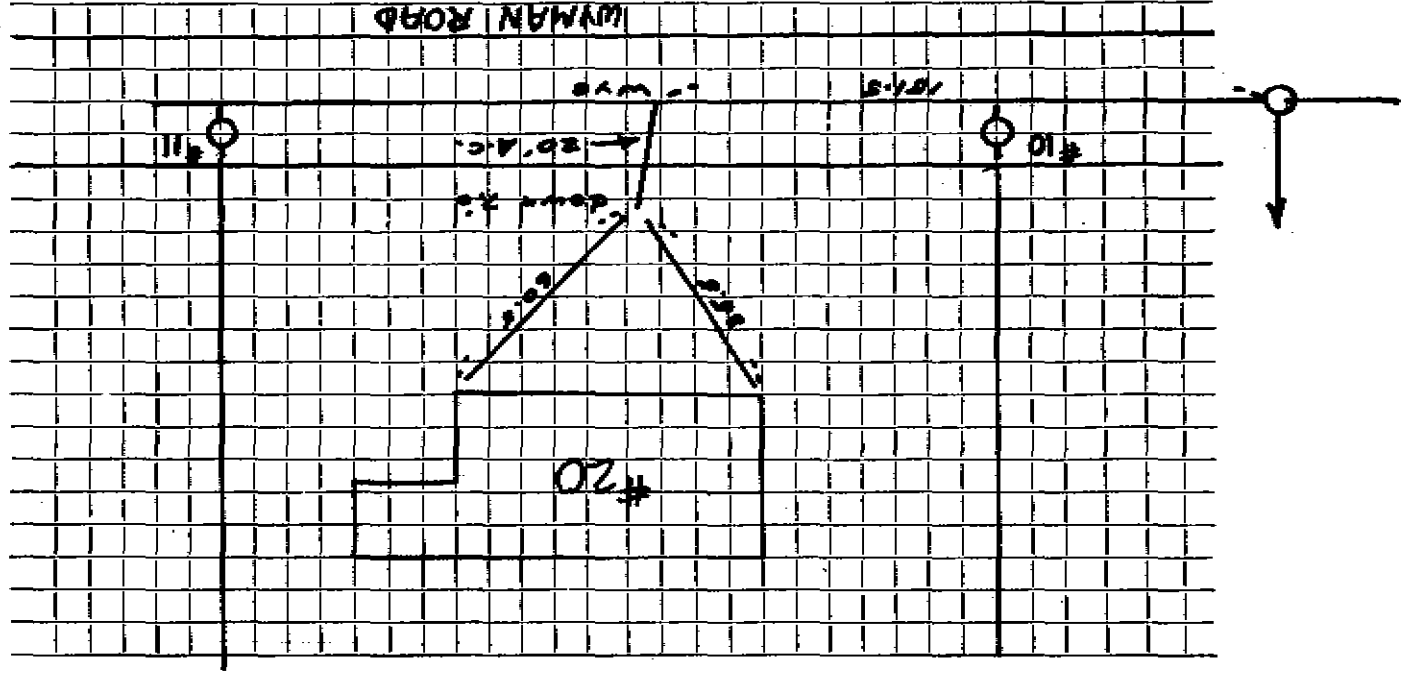

Connection made in Street. Work completed

Remarks: