


TOWN OF LEXINGTON — BOARD OF PUBLIC WORKS

SEWER DIVISION

DATE _____

Sketch of Service Here

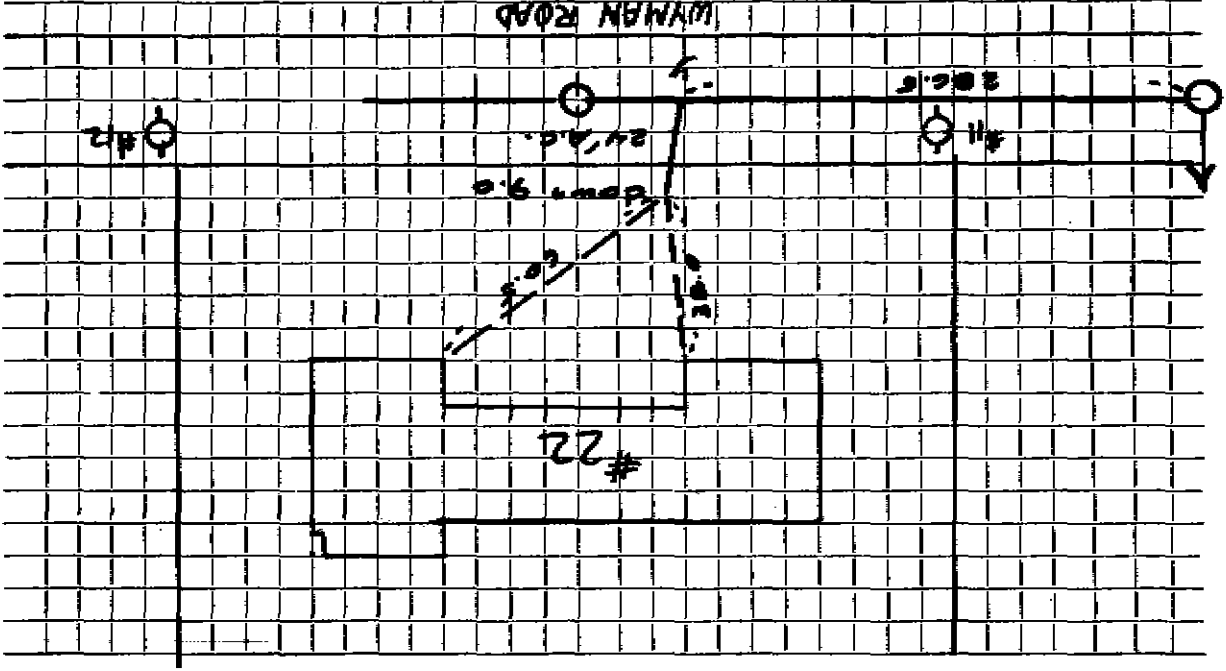

Street: _____ Work completed _____

Connection made in _____

Remarks: _____