

Name

Service No.

Address

23 Wynns Road

Location

Kind of Pipe

Size

Size of Main

Repair—Renewal—New Service

Location

Date

Material

Amount

Total


Date

Amount

DATE _____

TOWN OF LEXINGTON — BOARD OF PUBLIC WORKS
SEWER DIVISION

Sketch of Service Here

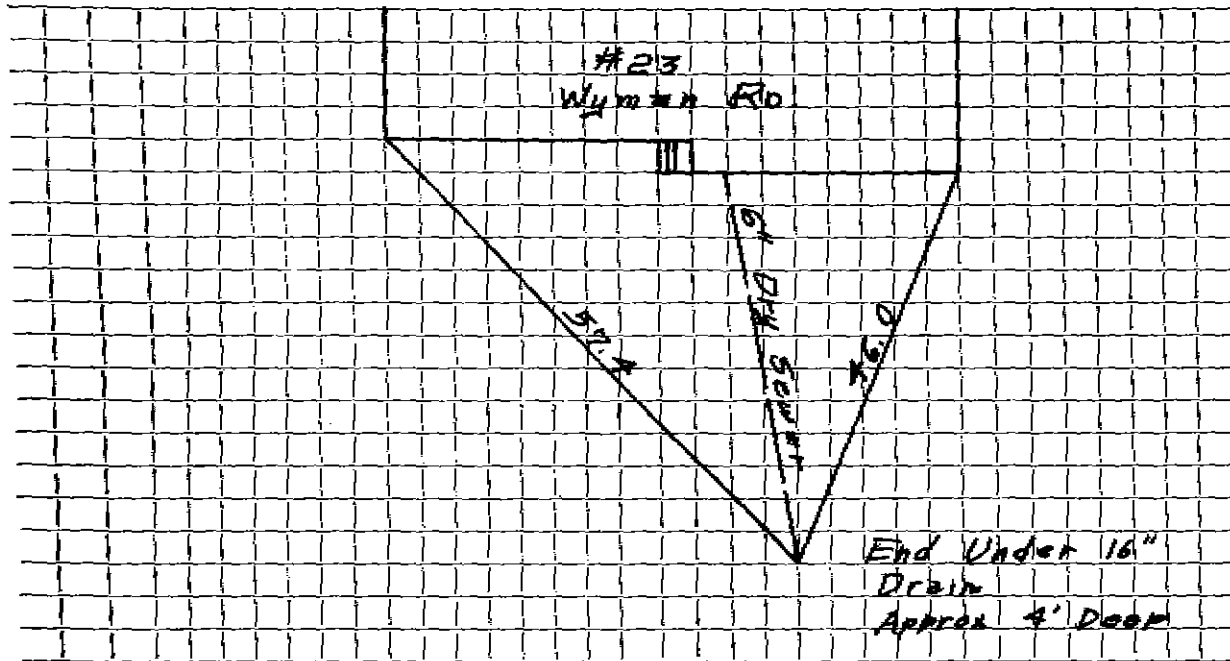


Connection made in Street. Work completed

Remarks:

DATE 6-26-98

TOWN OF LEXINGTON — BOARD OF PUBLIC WORKS
SEWER DIVISION

Sketch of Service Here

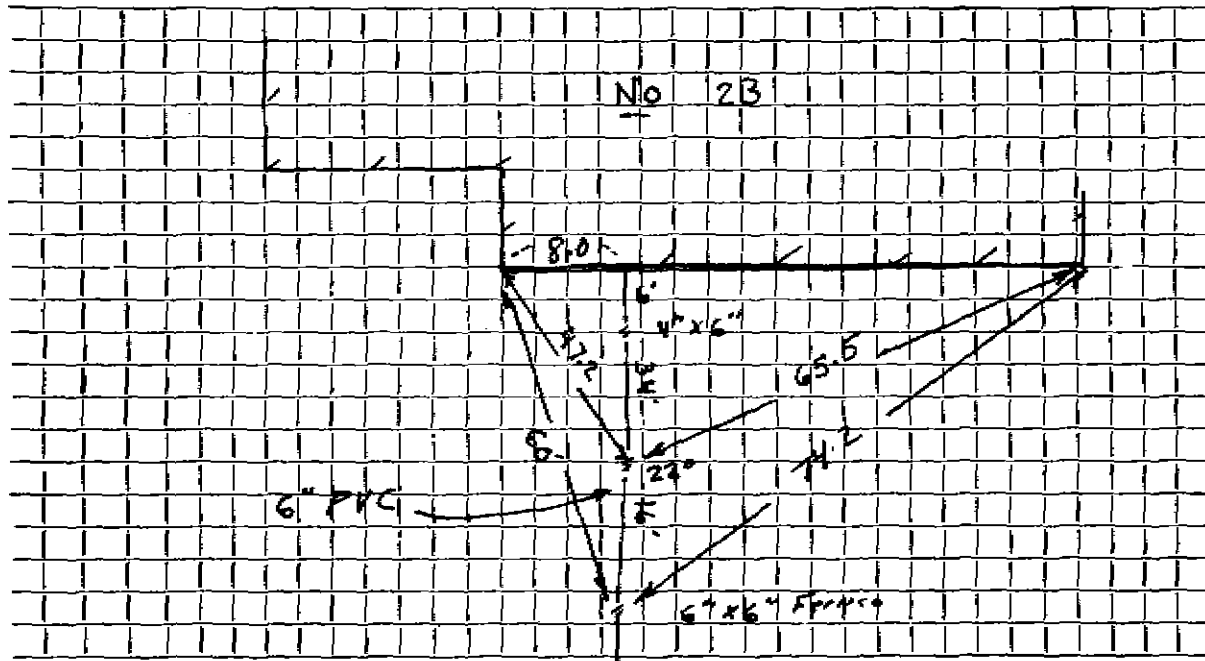

Connection made in Wyman RD Street. Work completed

Remarks:
.....
.....
.....

Name Walter A. Dodge

Service No. 110

Address • 23 WYMAN RD.

Location

Kind of Pipe A.C.

Size 6"

Size of Main 6"

Repair—Renewal—New Service

Location OCT 25 1976

Date	Material	Amount	Total	Date	Amount
------	----------	--------	-------	------	--------


10/2/74	12'A.C.	\$ 8.00	194.00	11-74	Deposit	144.00
---------	---------	---------	--------	-------	---------	--------

DATE _____

TOWN OF LEXINGTON — BOARD OF PUBLIC WORKS

SEWER DIVISION

Sketch of Service Here

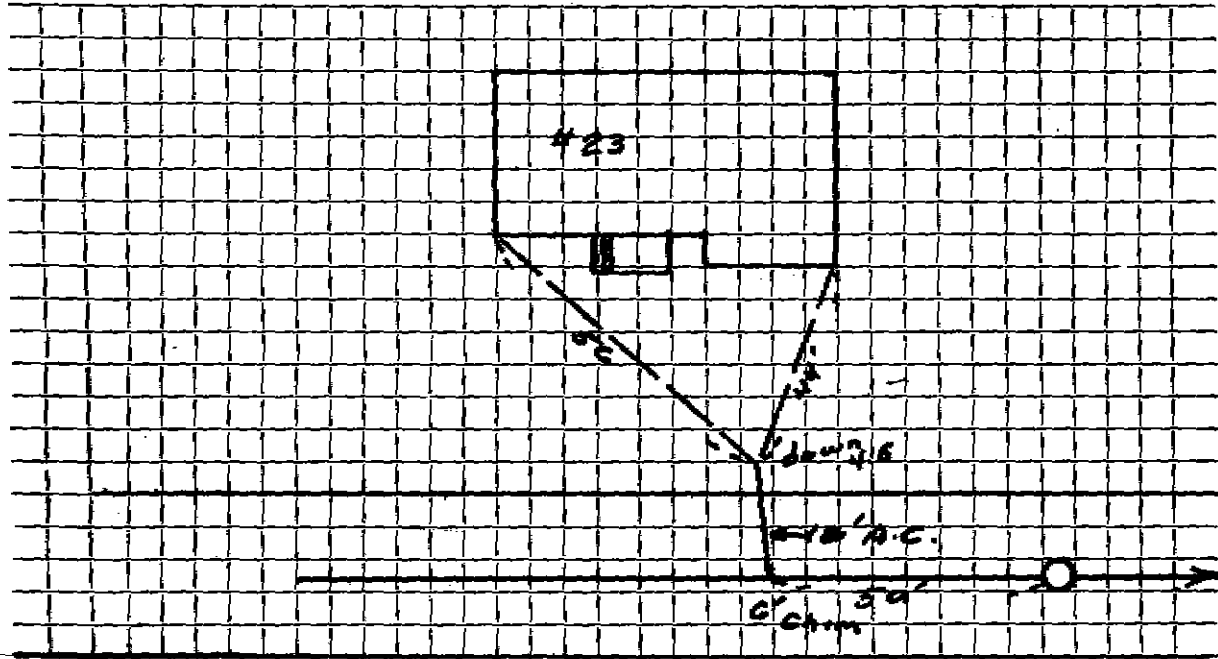

Connection made in Street. Work completed

Remarks:

.....

.....