


DATE July 9, 2020

TOWN OF LEXINGTON — BOARD OF PUBLIC WORKS
SEWER DIVISION

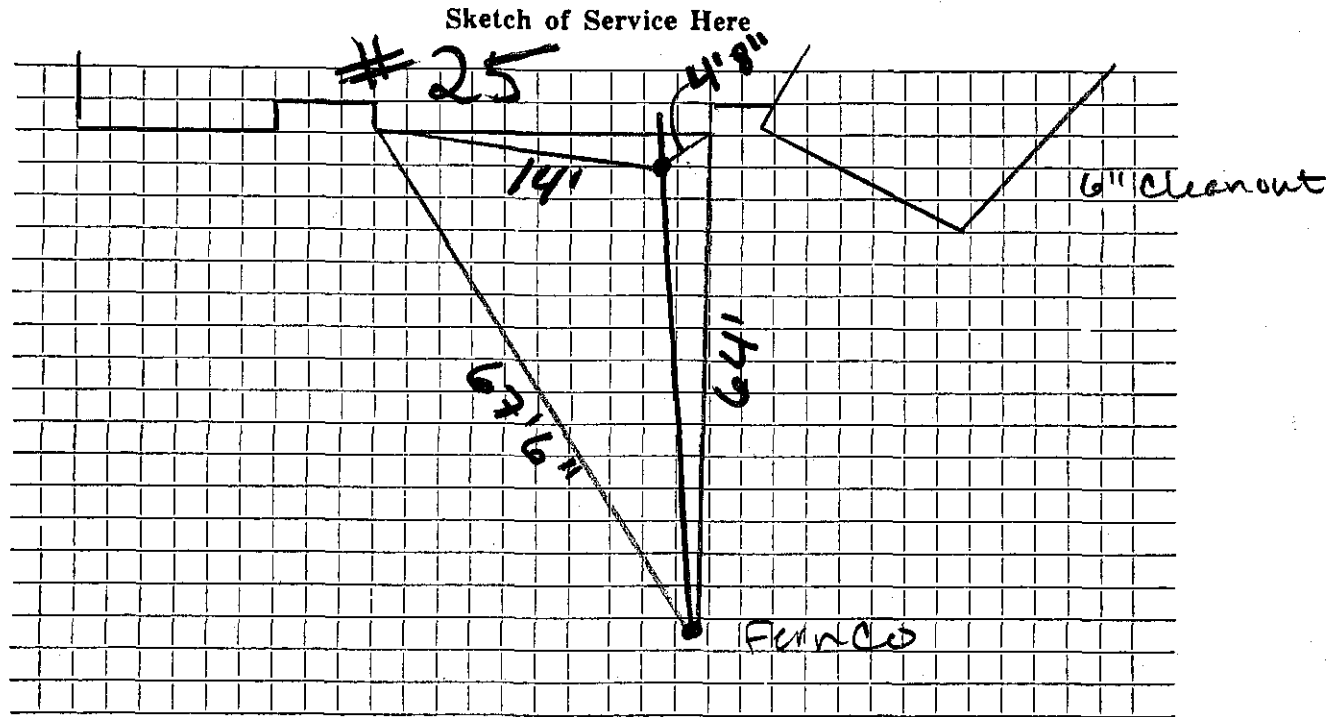

Connection made in Weyman Street. Work completed

Remarks:

.....

.....