




DATE NOV 5 1997

# TOWN OF LEXINGTON — BOARD OF PUBLIC WORKS SEWER DIVISION

Sketch of Service Here

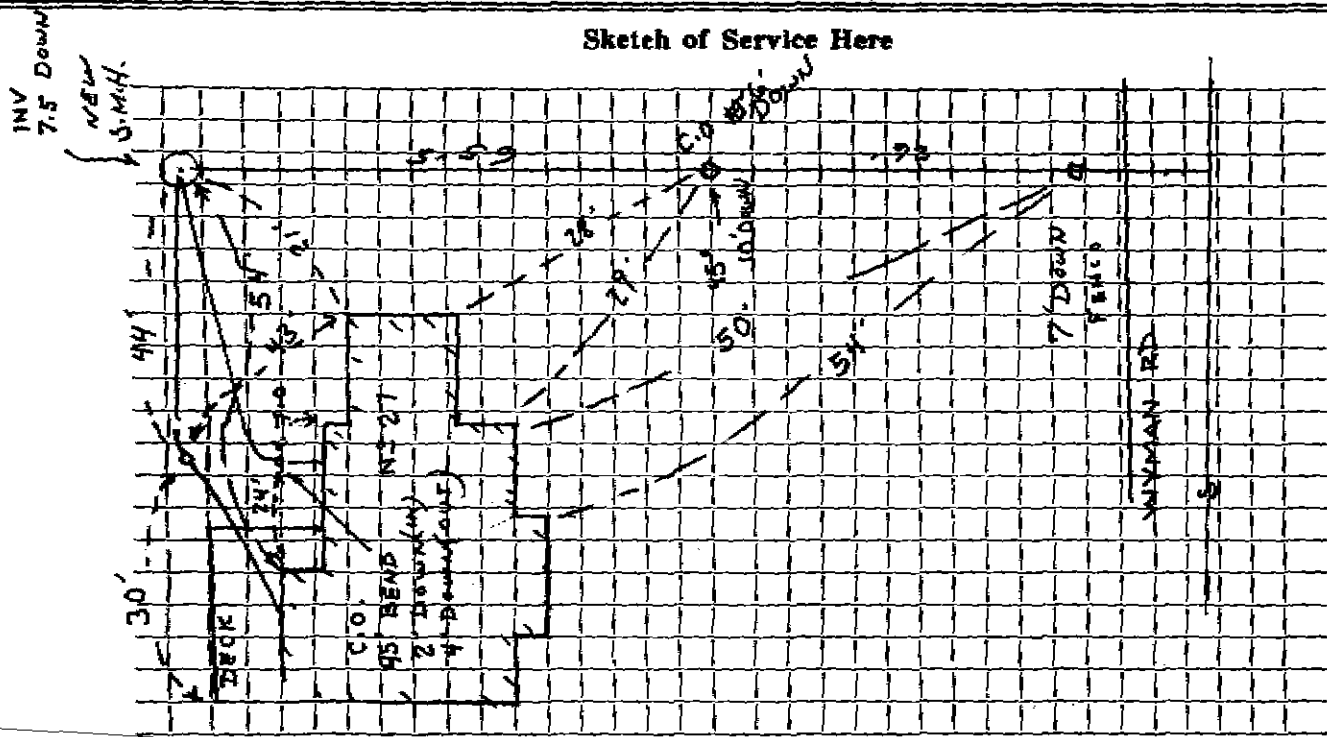

Connection made in WYMAN R.D. Street. Work completed PAUL ROSE

Remarks: .....

FIELD BOOK 97-4 TJM

Name

Service No.

Address

#27 Wyman Road

Location

Kind of Pipe

A.C.

Size

6"

Size of Main

8"

Repair—Renewal—New Service

Location

Date

Material

Amount

Total

Date

Amount

10/4/74

23' A.C.


\$8.00

\$184.00

DATE \_\_\_\_\_

**TOWN OF LEXINGTON — BOARD OF PUBLIC WORKS**  
**SEWER DIVISION**

Sketch of Service Here

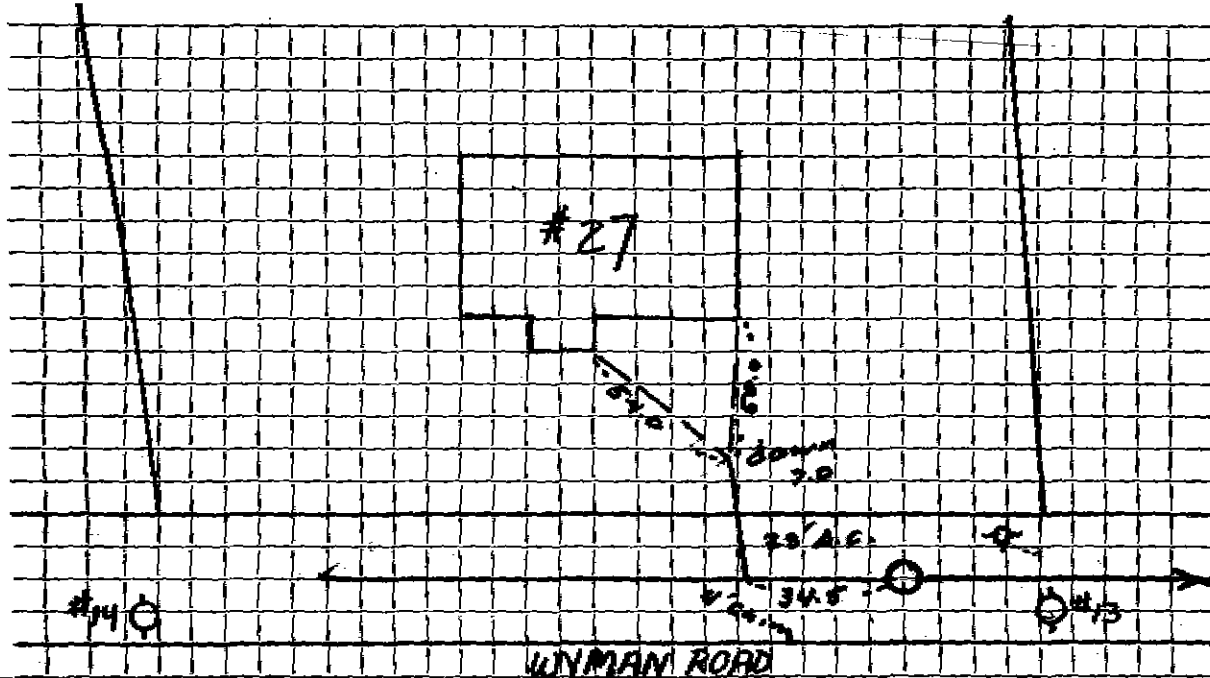

Connection made in ..... Street. Work completed .....

Remarks: .....  
.....  
.....