


SEWER DIVISION

Sketch of Service Here

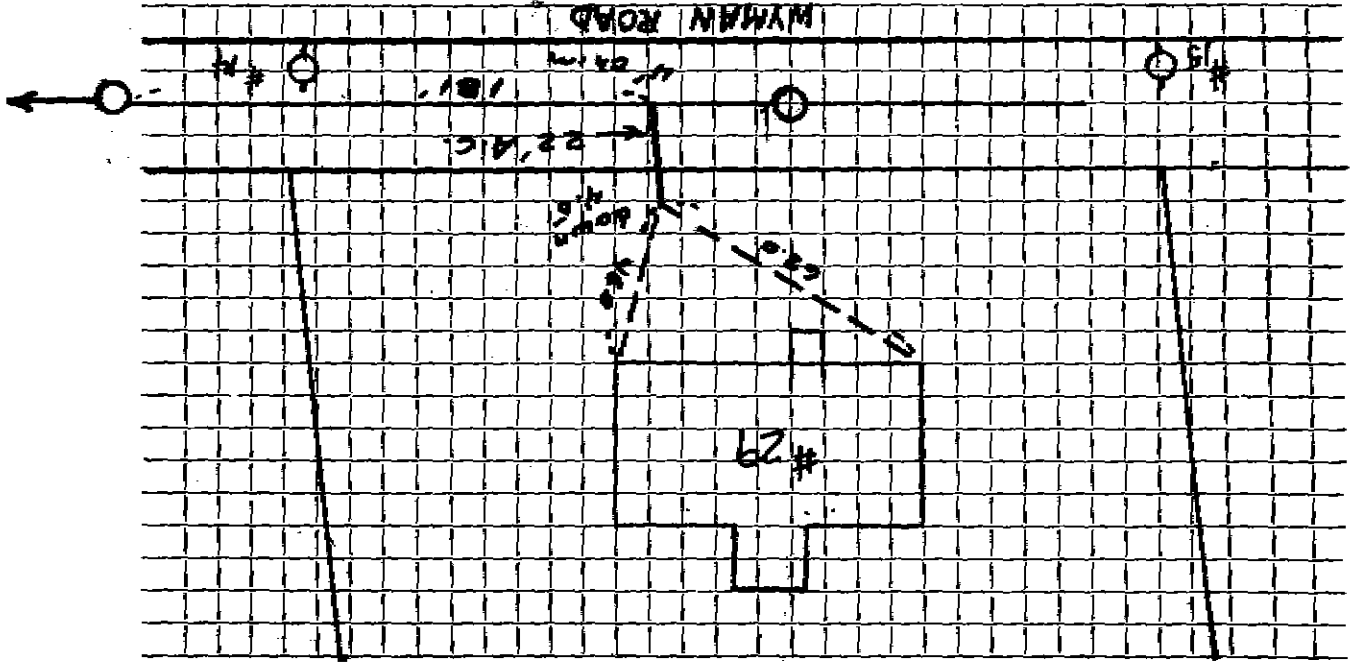

Connection made in _____ Street. Work completed

Remarks: _____