




DATE \_\_\_\_\_

# TOWN OF LEXINGTON — BOARD OF PUBLIC WORKS

## SEWER DIVISION

Sketch of Service Here

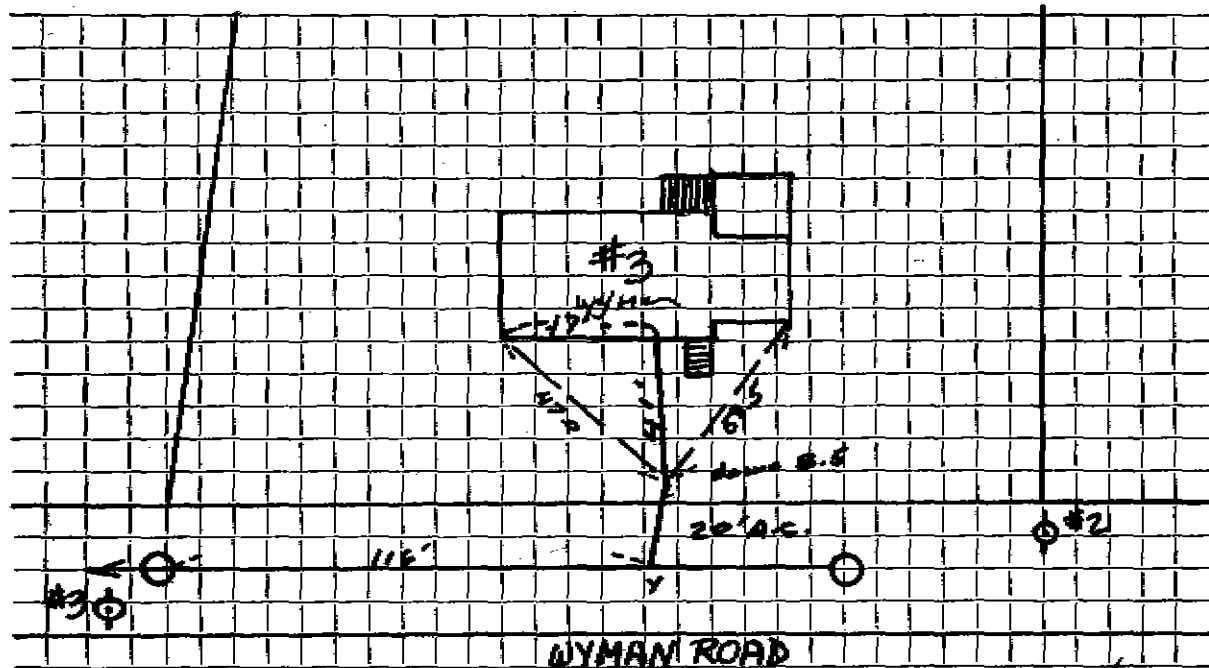

Connection made in 3. W. YMAN Street. Work completed 10/29/74

Remarks: .....

.....

.....