

Name John Moroney

Service No. 100

Address #34 Wymann Road

Location

Kind of Pipe A.C.

Size 6"

Size of Main 8"

Repair—Renewal—New Service Treblino #2550

Location AUG 18 1976


Date	Material	Amount	Total	Date	Amount	
10/17/74	19' A.C.	\$ 8.00	\$ 152.00	11/29/74	Deposit	152.00
11/21/74	34' 6" Transite Pipe					
	14' 4" Cast Iron Pipe					

TOWN OF LEXINGTON — BOARD OF PUBLIC WORKS

SEWER DIVISION

DATE _____

Sketch of Service Here

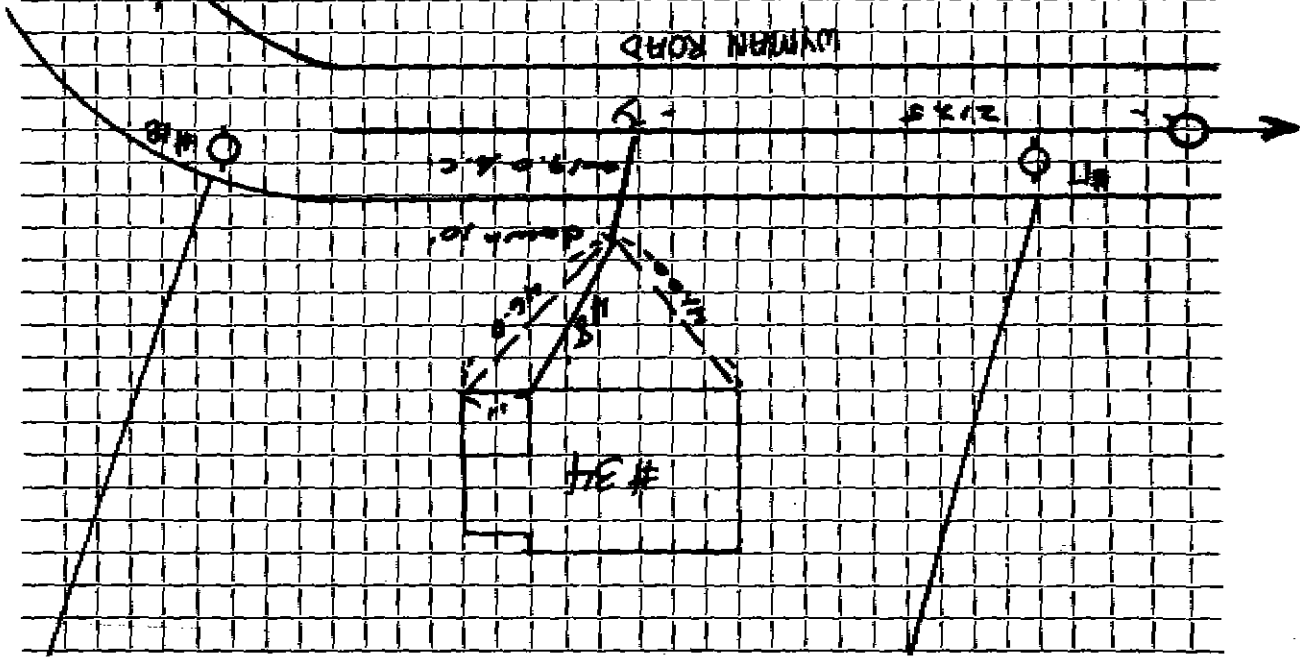

Connection made in 34 Lyman Rd. Street. Work completed 11/21/74

Remarks: