

Name Alan Glasser

Service No. 102

Address #36 Wyman Road

Location

Kind of Pipe A.C.

Size 6"

Size of Main 8"

Repair—Renewal—New Service Water #2590

Location OCT 25 1976

Date Material Amount Total Date Amount


10/27/74 13.0 A.C. \$ 8.00 \$ 104.00 10/29/76 Deposit 104.00

TOWN OF LEXINGTON — BOARD OF PUBLIC WORKS

SEWER DIVISION

DATE \_\_\_\_\_

Sketch of Service Here

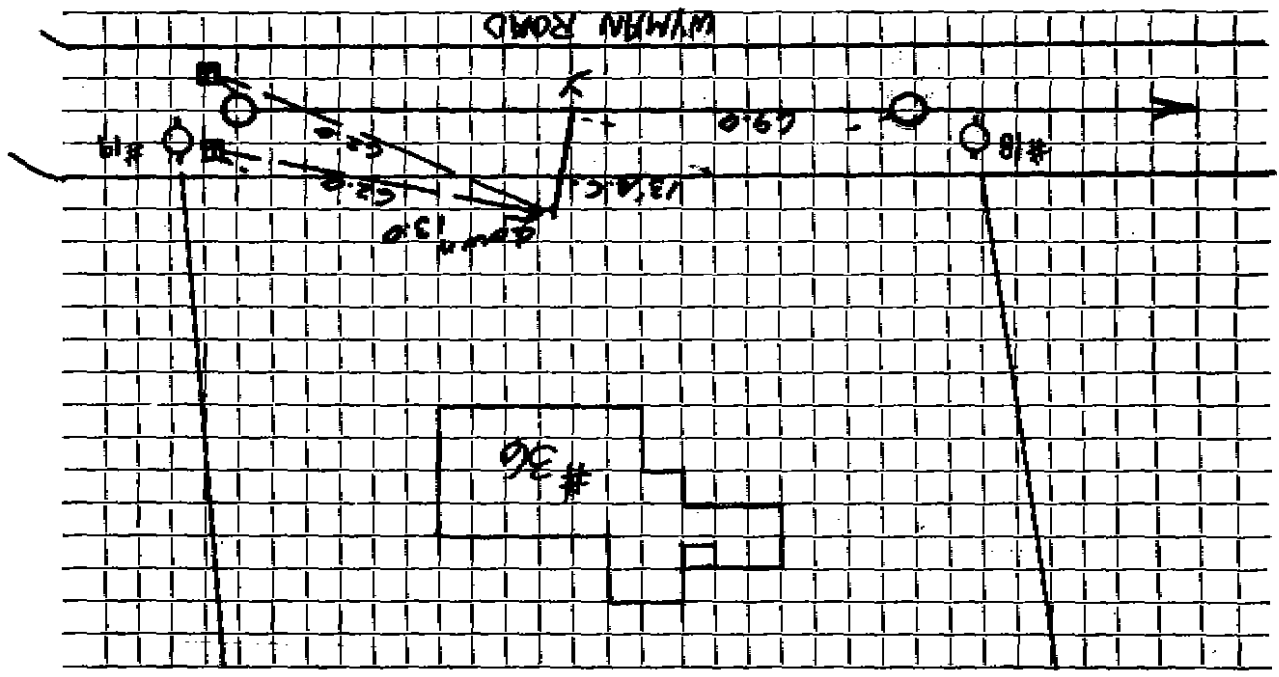

Street: \_\_\_\_\_  
Work completed \_\_\_\_\_

Connection made in \_\_\_\_\_

Remarks: \_\_\_\_\_  
\_\_\_\_\_  
\_\_\_\_\_