

Name Alvin Block

Service No. 87

Address # 37 Wymon Road

Location

Kind of Pipe A.C.

Size

6"

Size of Main 6"

Repair—Renewal—New Service

6/12/74 # 2574

Location

OCT 25 1976


Date	Material	Amount	Total	Date	Amount
10/17/74	21' A.C.	\$ 8.00	\$ 116.00	11-21-74	Deposit

TOWN OF LEXINGTON — BOARD OF PUBLIC WORKS

SEWER DIVISION

DATE _____

Sketch of Service Here

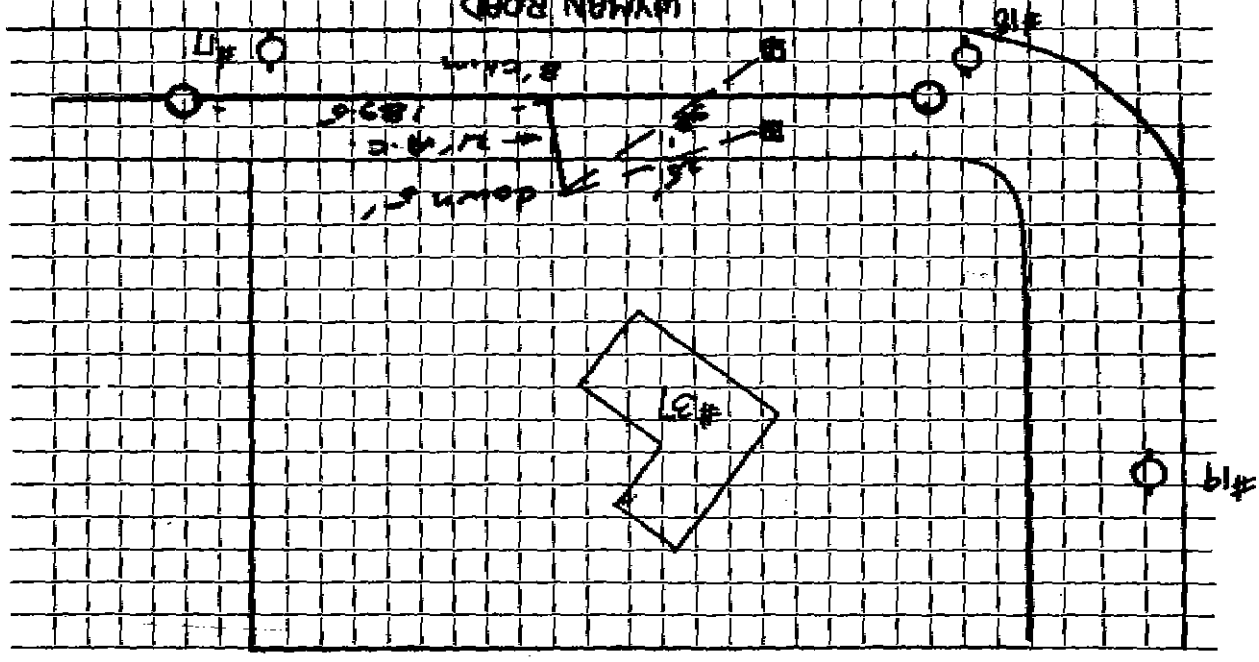

Connection made in _____ Street. Work completed _____

Remarks: _____