


TOWN OF LEXINGTON — BOARD OF PUBLIC WORKS
DATE _____

SEWER DIVISION

Sketch of Service Here

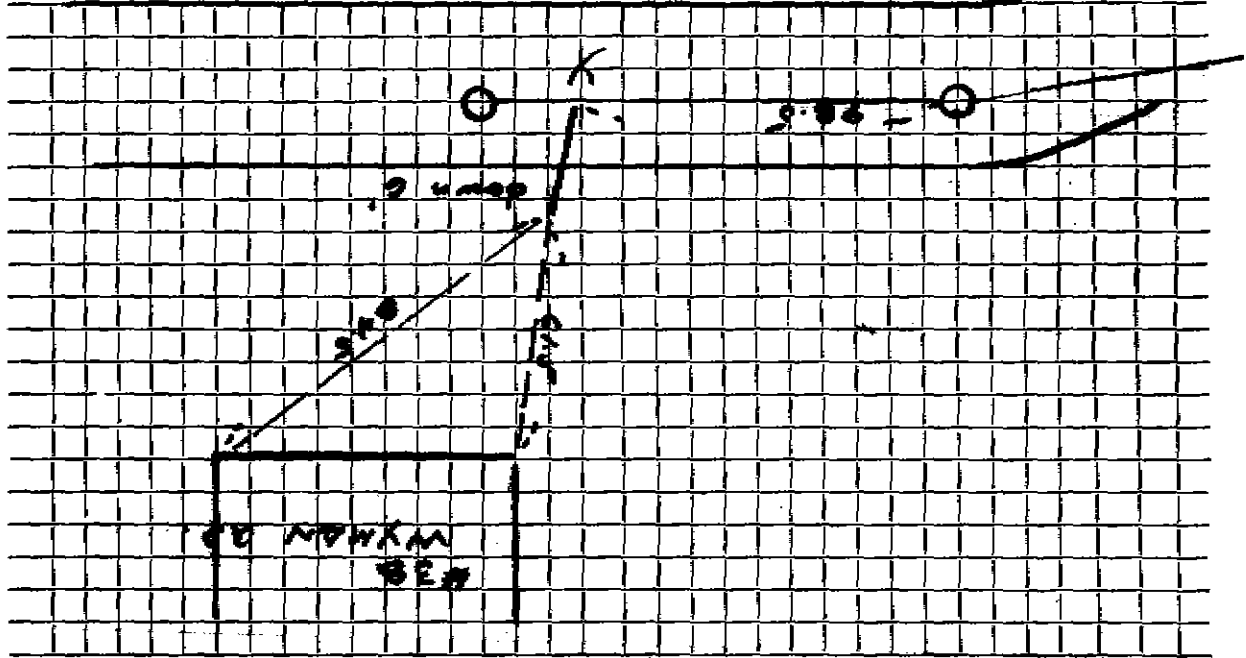

Work completed

Street.

Connection made in

Remarks:

