




DATE 1974

TOWN OF LEXINGTON — BOARD OF PUBLIC WORKS  
SEWER DIVISION

Sketch of Service Here

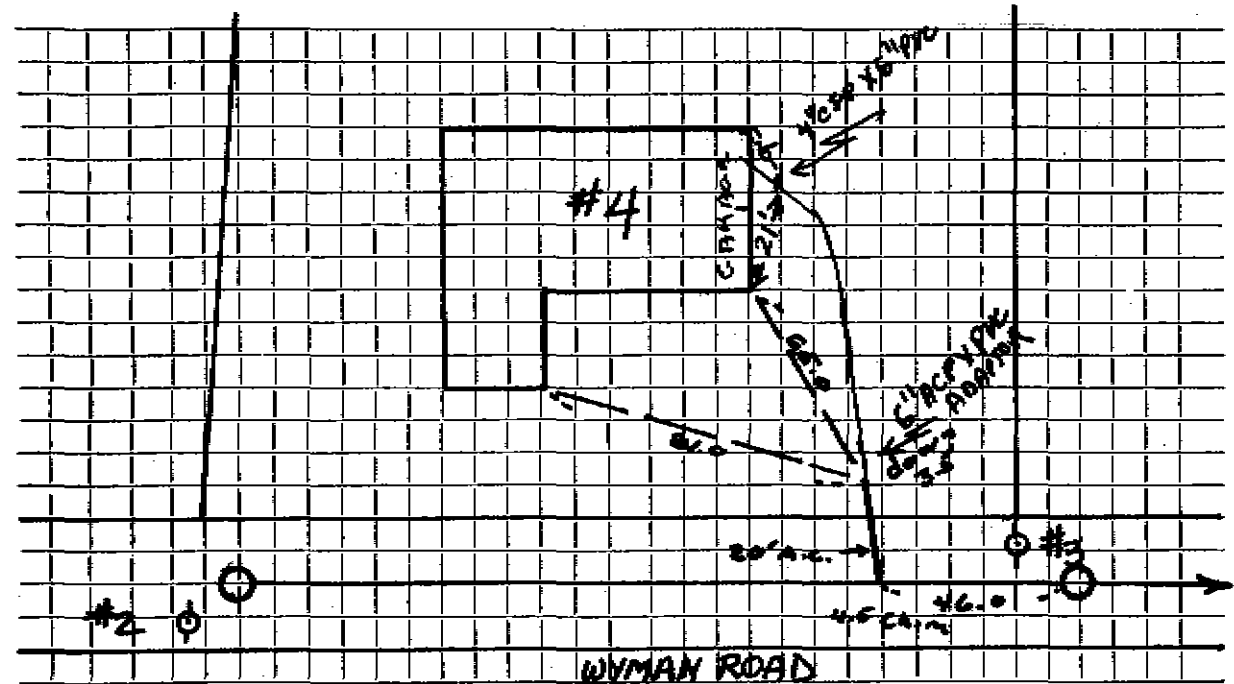

Connection made in WYMAN ROAD ..... Street. Work completed SEPT. 9, 1985 .....

Remarks: .....

.....

.....