


DATE _____

TOWN OF LEXINGTON — BOARD OF PUBLIC WORKS

SEWER DIVISION

Sketch of Service Here

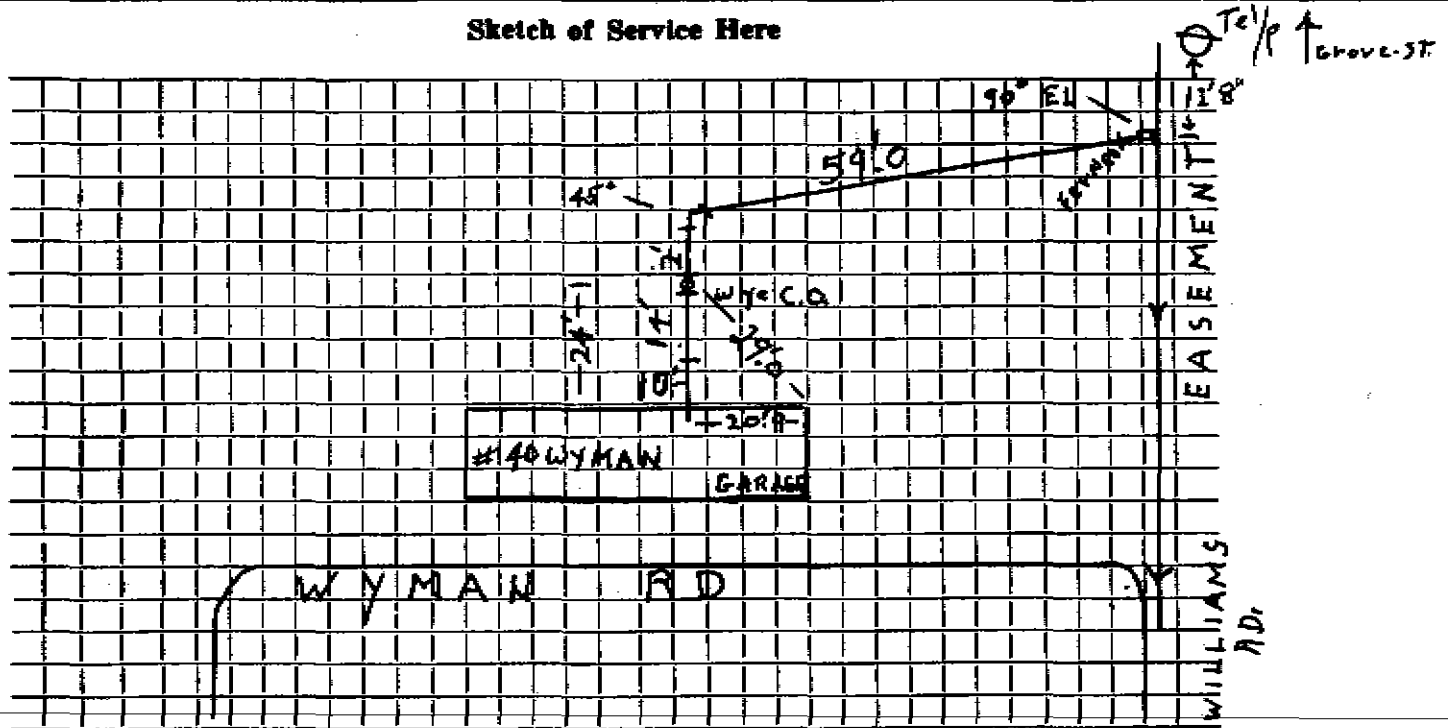

Connection made in EASEMENT Street. Work completed 11/10/06 Standard Const.

Remarks: Trace Taps over Sewer Pipe