

Service No.

Name 5 Wyman Rd
Address

Location

Kind of Pipe PVC

Repair—Reinsert—New Service Avlex 01

Size of Main


Location

Date	Material	Amount	Total	Date	Amount
9/22/06	4" PVC				
	6" PVC				
	Cleanout				
	Exit				
	STub				

Remarks:

400

..... Street. Work completed 9/22/06 Alex.

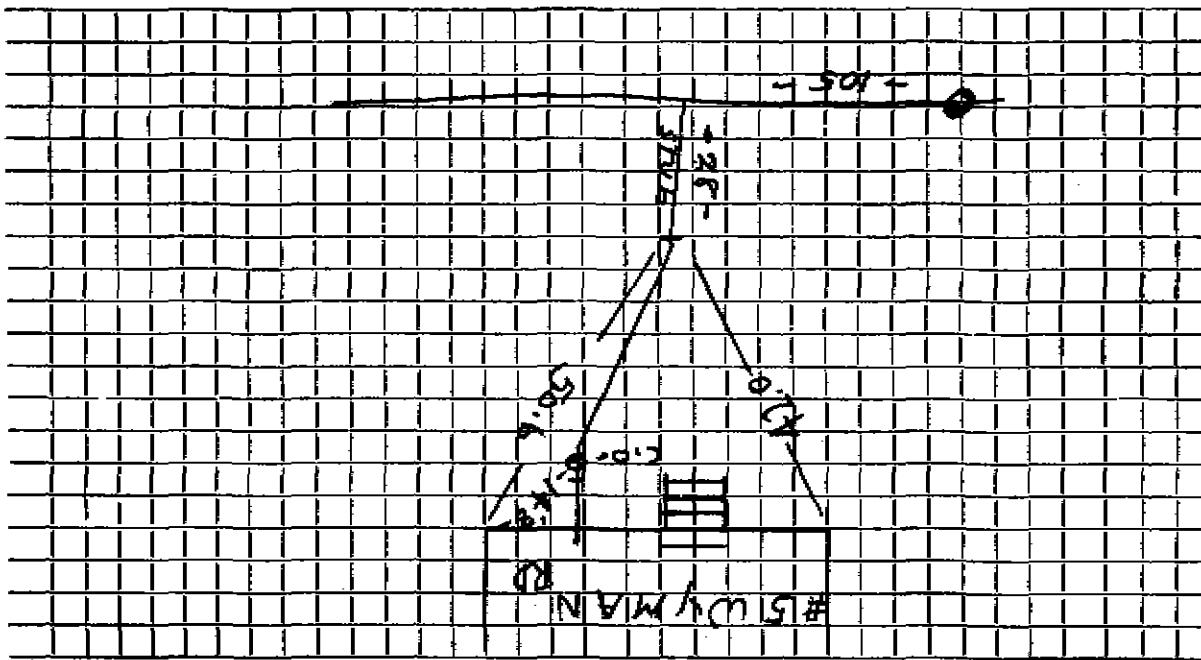

Sketch of Service Here

SEWER DIVISION

TOWN OF LEXINGTON — BOARD OF PUBLIC WORKS

-31-