


DATE _____

TOWN OF LEXINGTON — BOARD OF PUBLIC WORKS
SEWER DIVISION

Sketch of Service Here

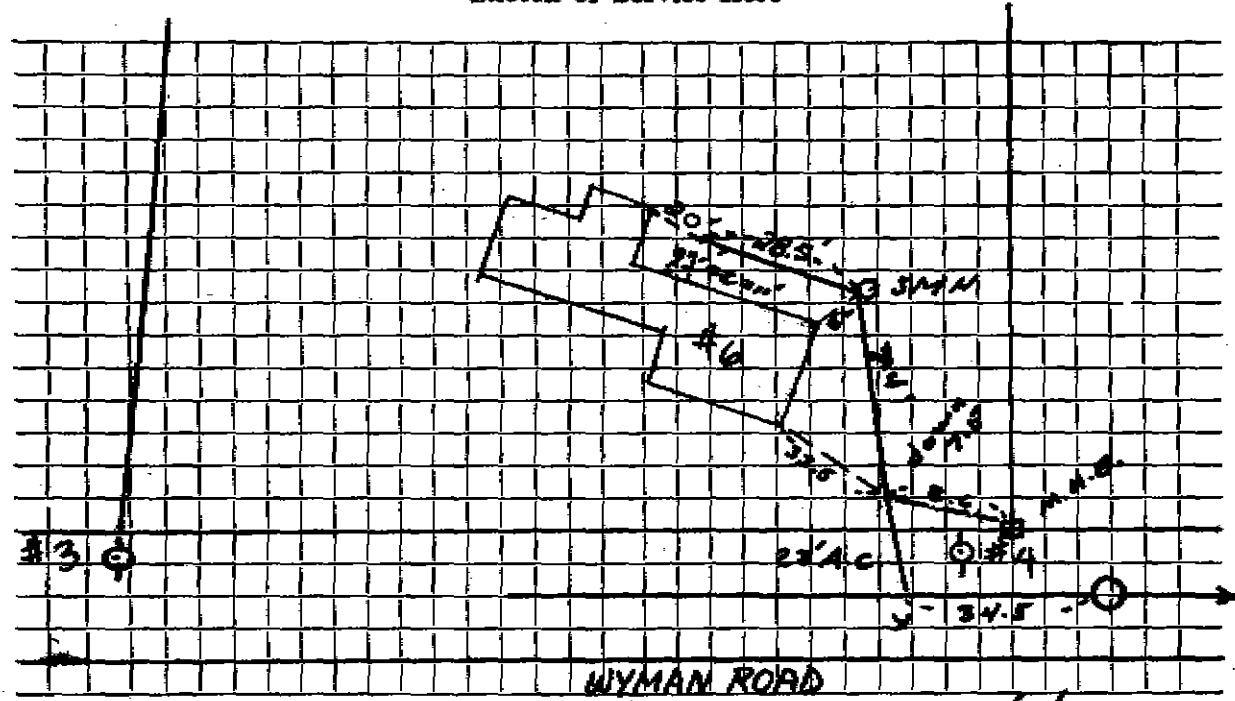

Connection made in Gr Wyman Rd..... Street. Work completed ... 5/6/76.....

Remarks:

.....

.....