

Name

Contractor: Jay Ron

Service No.

Address

7 Wyman Rd

Location

Kind of Pipe

SDR35 PVC

Size

6"

Size of Main

Repair

~~Renewal~~

New Service

Location

Date

Material

Amount

Total

Date

Amount

7/26/19

4" cleanout

6" PVC pipe

22° bend

6" PVC pipe

22° bend


6" PVC pipe

Fern Co

DATE 7/26/19

TOWN OF LEXINGTON — BOARD OF PUBLIC WORKS
SEWER DIVISION

Sketch of Service Here

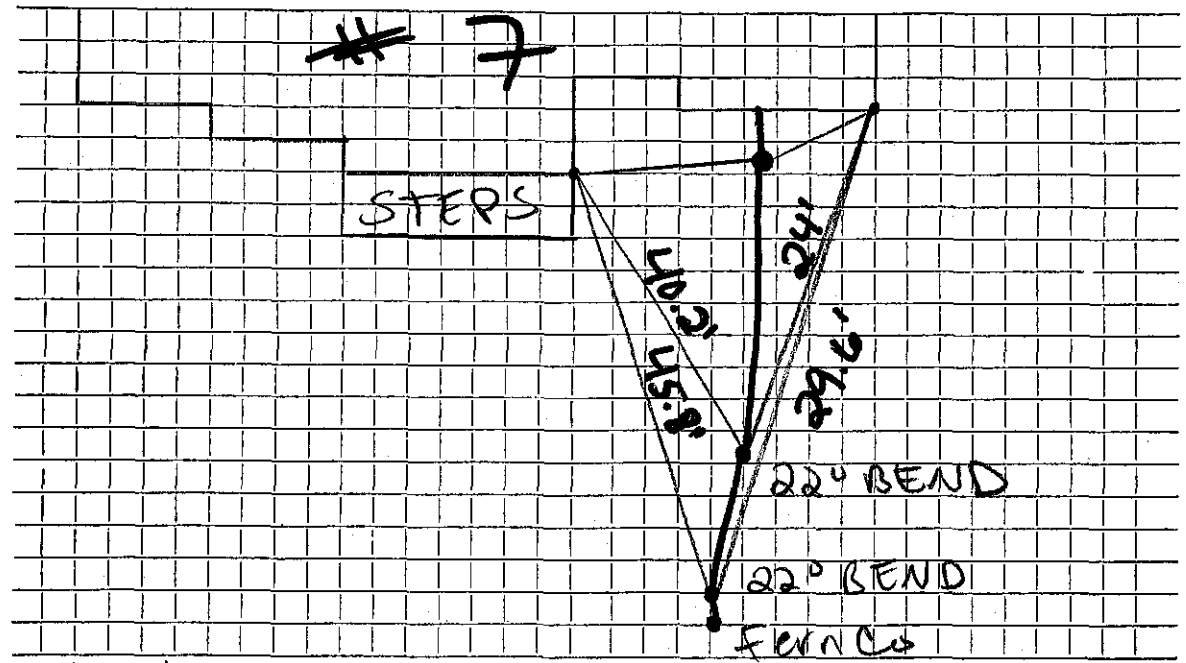

Connection made in B. Wyman Street. Work completed

Remarks: