

Name Murray Dennis

Service No. 41

Address #20 YORK ST.

Location

Kind of Pipe A.C.

Size 6"

Size of Main 8"

~~Repair/ Renewal~~ New Service Valeri #3823

Location OCT 31 1983


| Date | Material | Amount | Total | Date | Amount |
|---------|---------------------------|----------|-------|---------|-------------------|
| 8/16/83 | 25'-6" A.C.P. @ 9.00 | \$225.00 | | 9-15-83 | Deposit 225.00 |
| 9/23/83 | 46' x 6" P.V.C. | | | | |
| | 1 P.V.C. Wye | | | | |
| | 1 6" Cap | | | | |
| | 1 P.V.C. x A.C.P. Adaptor | | | | |
| | | | | | |
| | | | | | |
DATE _____

TOWN OF LEXINGTON — BOARD OF PUBLIC WORKS

SEWER DIVISION

Sketch of Service Here

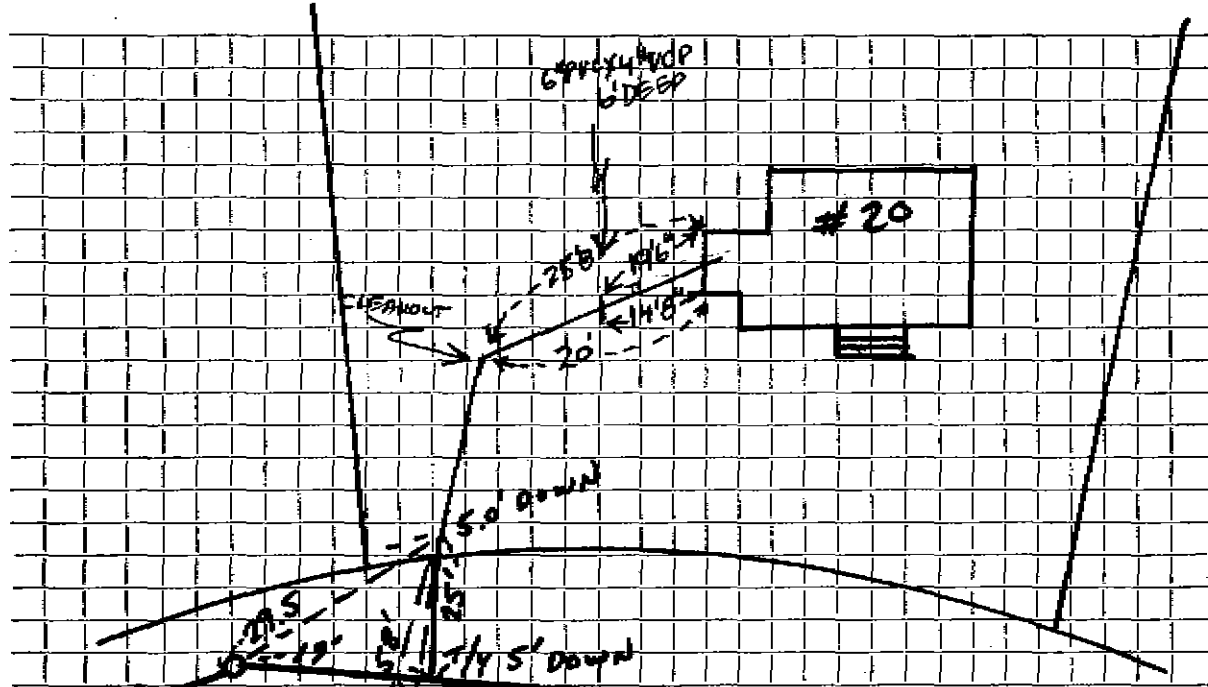

Connection made in SMH #22 43 Street. Work completed SMH #23

Remarks:

.....

.....