

Name Chester Jordan

Service No. 123

Address 24 YORK ST.

Location

Kind of Pipe A.C.

Size 6"

Size of Main 8"

Repair—Renewal—New Service Tubing #3661


Location OCT 25 1976

Date	Material	Amount	Total	Date	Amount
8/20/73	24'-6" A.C. P	\$216.00		11-18-74	Deposit 316.00
12/9/74	50'-6" TRANS TUBING				

DATE _____

TOWN OF LEXINGTON — BOARD OF PUBLIC WORKS
SEWER DIVISION

Sketch of Service Here

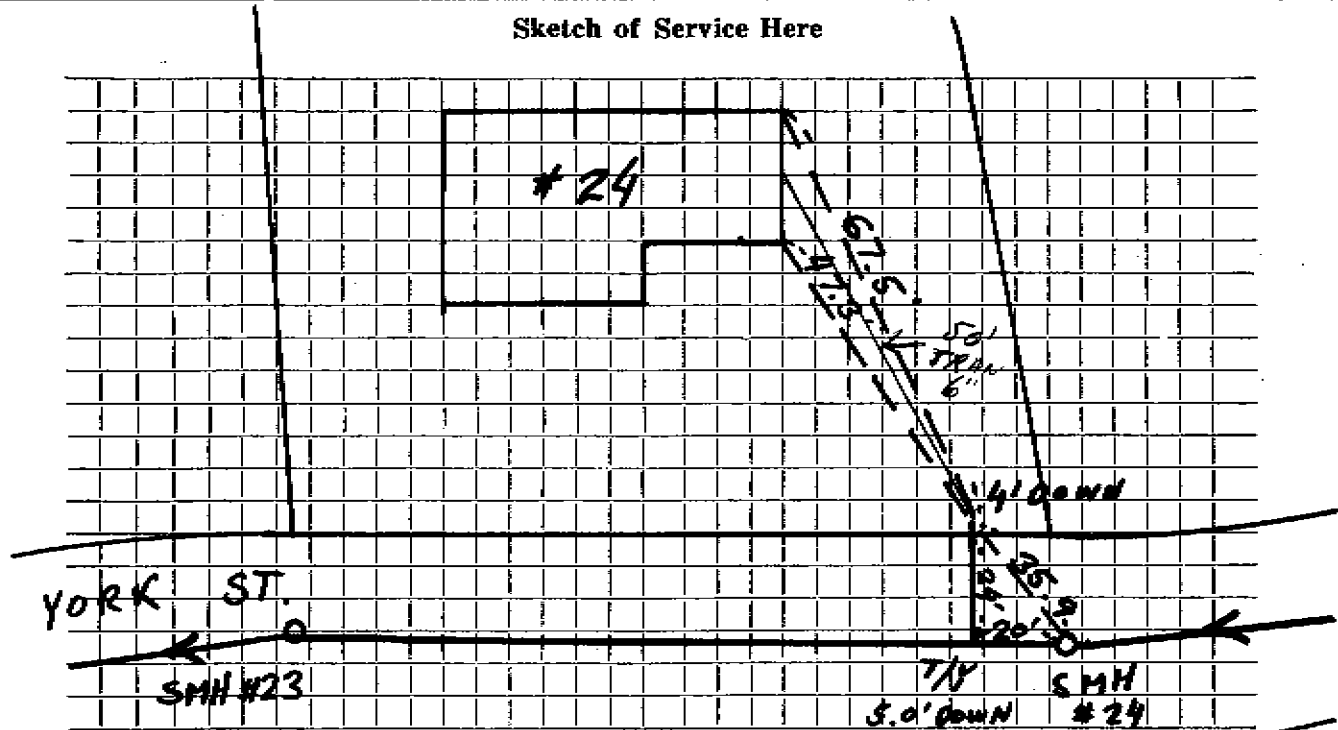

Connection made in _____ Street. Work completed _____

Remarks: _____
