

Name

Ms. Mimi King

Service No.

131

Address

27 YORK ST.

Location

Kind of Pipe

A.C.

Size

6"

Size of Main

8"

Repair—Renewal—New Service

2x Sewerage 2687

Location

OCT 25 1976

Date

Material

Amount

Total

Date

Amount

8/24/73

27.0' - 6" A.C.P. @ 9.00

243.00

12-15-74


Deposit

243.00

DATE _____

TOWN OF LEXINGTON — BOARD OF PUBLIC WORKS
SEWER DIVISION

Sketch of Service Here

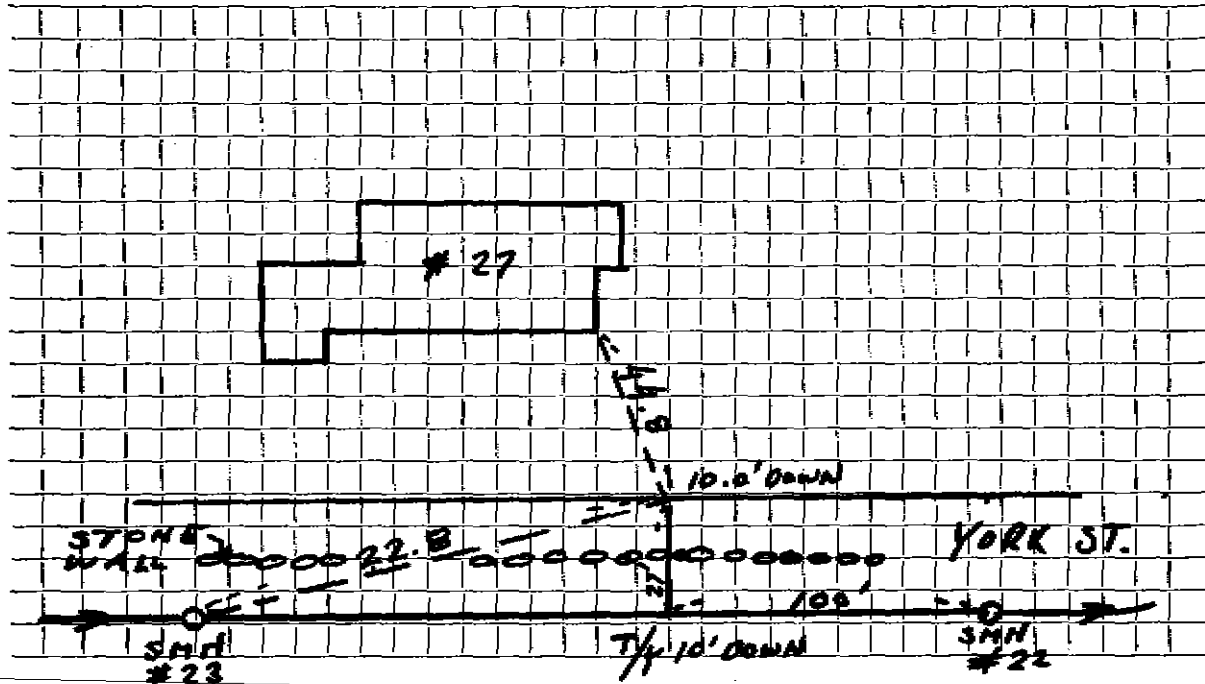

Connection made in Street. Work completed

Remarks:
.....
.....