

Name Edward Haines

Service No. 13

Address 33 YORK ST.

Location

Kind of Pipe A.C.

Size 6"

Size of Main 8"

~~Repair~~ New Service Valeri #4386


Location

Date	Material	Amount	Total	Date	Amount
8/21/73	39'-6" A.C.P. @ \$9.00	\$351.00		4-16-87	Deposit 351.00
6/3/87	90' 4" 6" P.V.C.				
	1 4 x 4 to PVC Fernco				
	1 22° Sweep 4"				
	1 22° El 4"				
	1 4 x 6				
	2 6 x 6 Wye				
	2 6 x 6 45°				
	2 6" PVC Caps				
	1 6 x 6 AC to PVC Fernco				

DATE

TOWN OF LEXINGTON — BOARD OF PUBLIC WORKS SEWER DIVISION

Sketch of Service Here

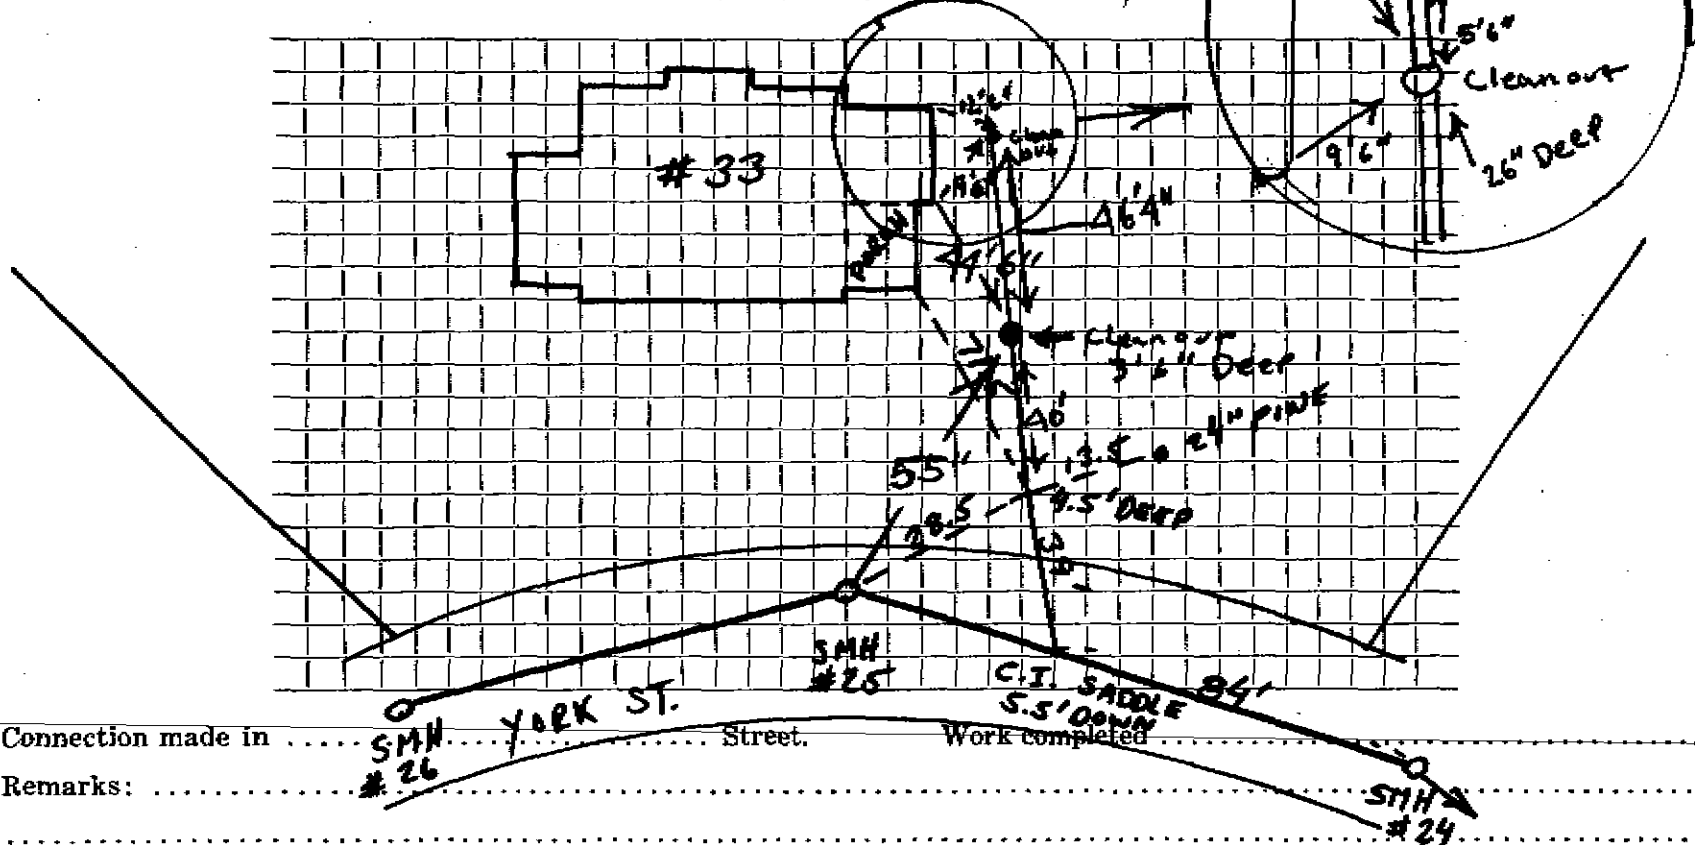

Connection made in SMH #26 YORK ST. Street.

Work completed

Remarks:

.....
.....