

Name RICHARD FELISS

Service No.

Address #39 YORK AVENUE

Location

Kind of Pipe

Size

BRASS 1 1/2" x 1/2"

Size of Main

Repair—Renewal—

New Service

SEPTIC ABANDONMENT PERMIT NO. 0702

Location

Date

Material

Amount

Total

Date


Amount

10/2 95 58'-6" P.V.C.

DATE 2 OCTOBER 1995

TOWN OF LEXINGTON — BOARD OF PUBLIC WORKS
SEWER DIVISION

Sketch of Service Here

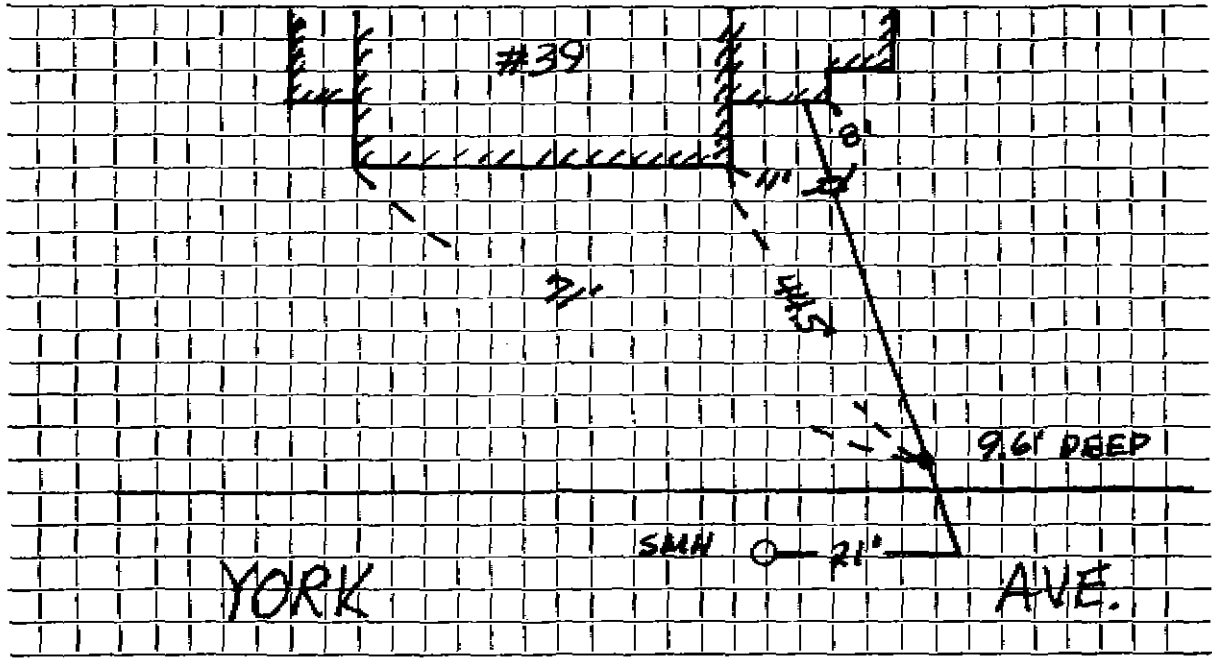

Connection made in YORK AVENUE Street. Work completed BRUCE MCKEE

Remarks:


BOOK 94A

J.W.

DATE _____

TOWN OF LEXINGTON — BOARD OF PUBLIC WORKS
SEWER DIVISION

Sketch of Service Here

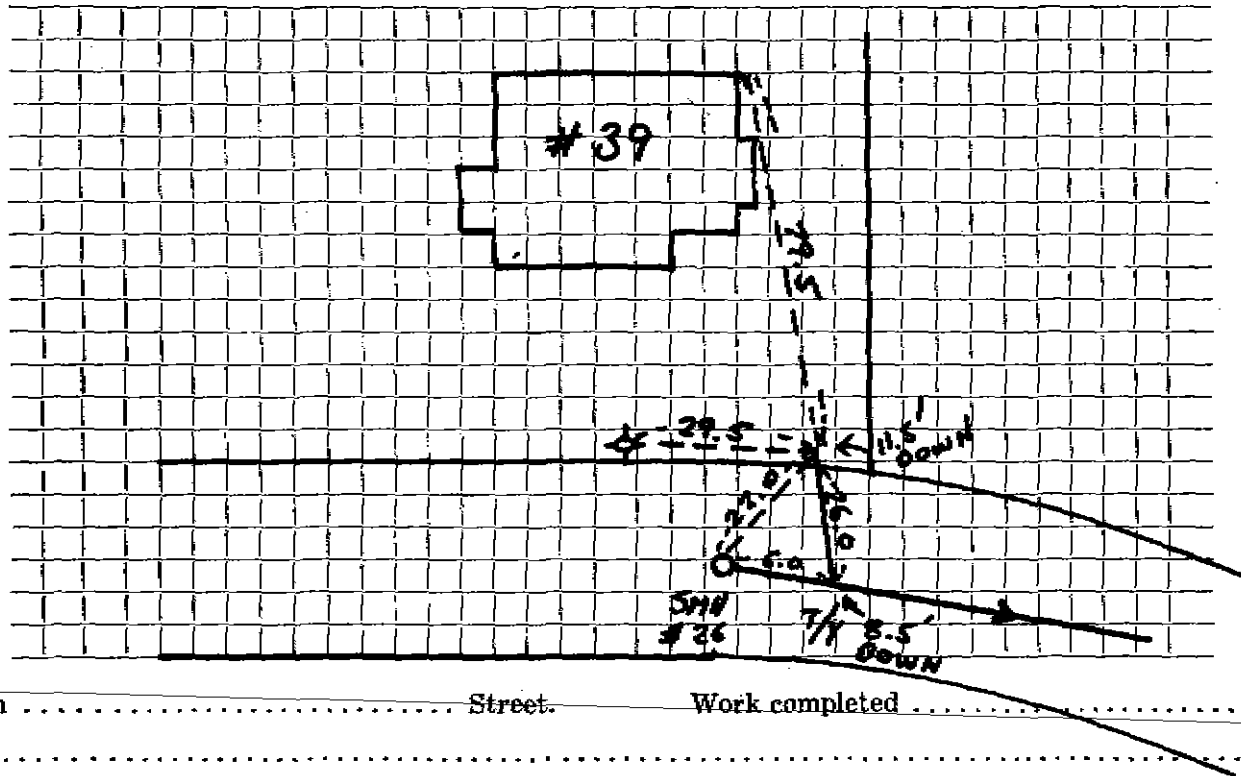

Connection made in Street. Work completed

Remarks:

.....

.....