

Name Ashton Little

Service No. 168

Address 43 York St.

Location

Kind of Pipe

Size

Size of Main

Repair—Renewal—New Service Trebing Const. # 2428


Location APR 8 1974

Date	Material	Amount	Total	Date	Amount	
8-16-73	30' 6" Transit Pipe @ 9.00		180.00	11-14-73	Deposit	180.00
11-14-73	105' - 6" ACP					
	12.5' - 4" CI					

DATE _____

TOWN OF LEXINGTON — BOARD OF PUBLIC WORKS
SEWER DIVISION

Sketch of Service Here

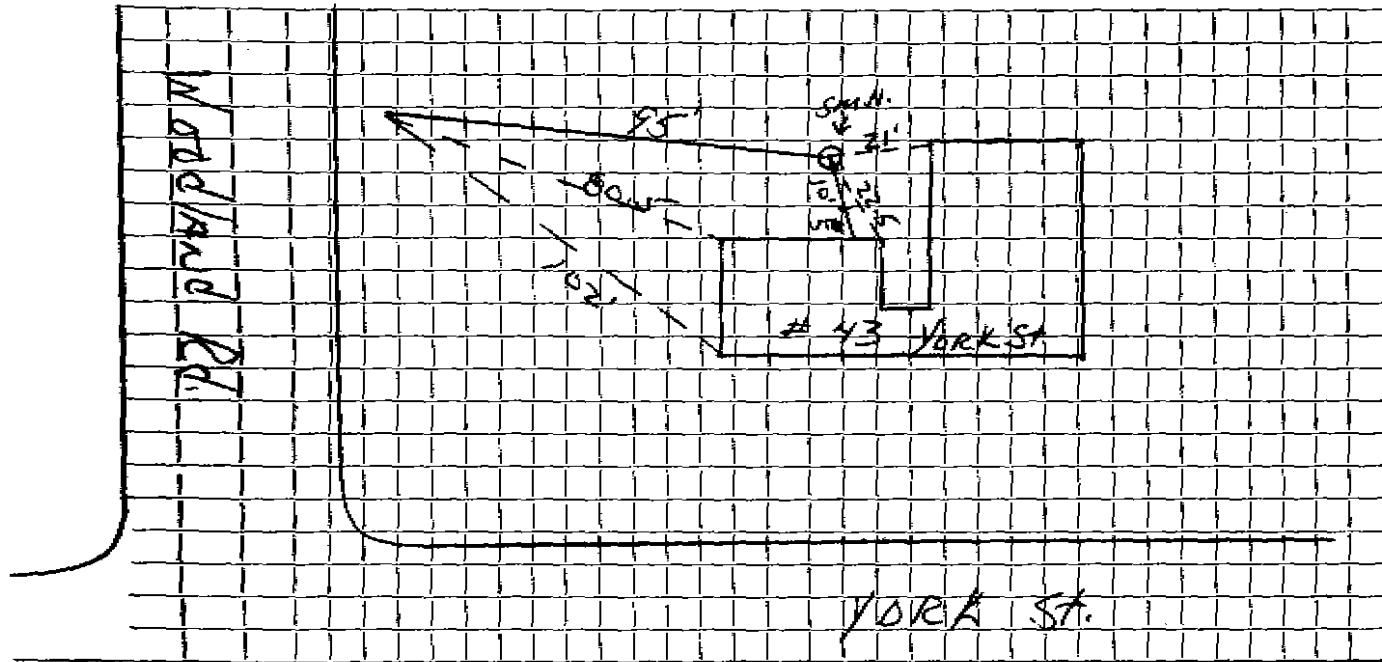

Connection made in Street. Work completed

Remarks:

.....

.....