




DATE FEB 26 1998

TOWN OF LEXINGTON — BOARD OF PUBLIC WORKS  
SEWER DIVISION

Sketch of Service Here

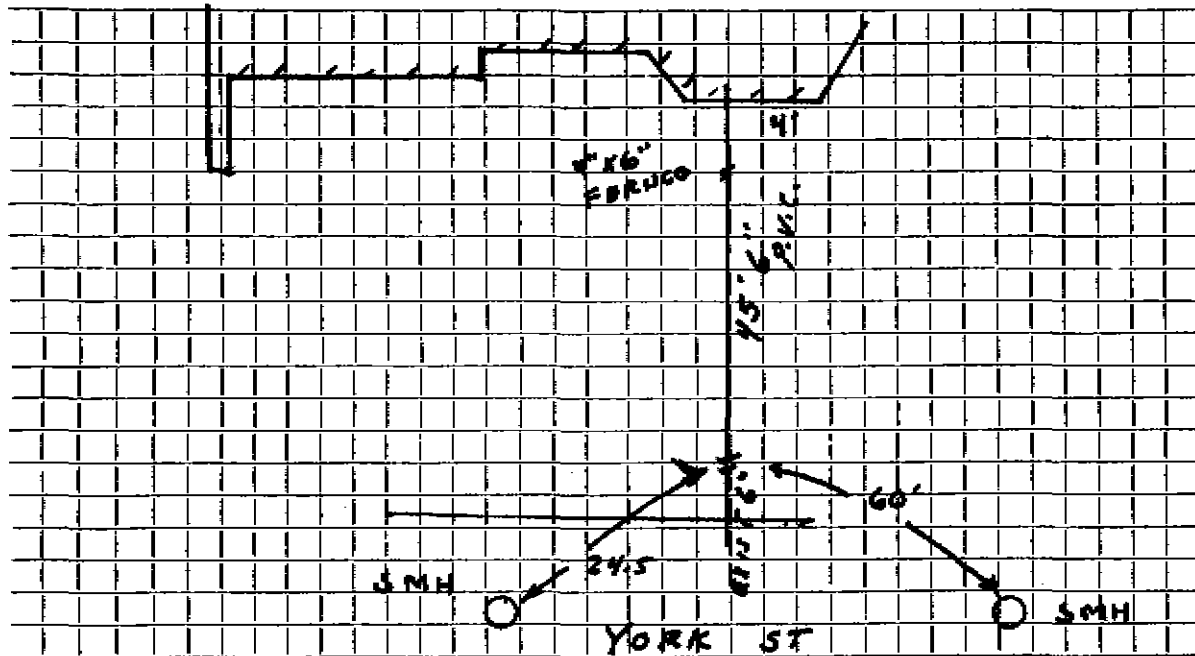

Connection made in YORK ST Street. Work completed J. M. McLAUGHLIN

Remarks: .....  
.....  
..... FIELD BOOK 98-1 .....

Name Lemuel M. Bottoms

Service No. 91

Address 44 YORK ST.

Location

Kind of Pipe A.C.

Size 6"

Size of Main 8"

Repair—Renewal—New Service

LEXINGTON SEWERAGE  
#3189

Location

FEB 13 1978


Date	Material	Amount	Total	Date		Amount
------	----------	--------	-------	------	--	--------

8/10/73	26.0'-6" A.C. P&S	19.00	\$ 234.00	11-13-77	Deposit	234.00
10-31-77	4" Transit pipe					

DATE \_\_\_\_\_

TOWN OF LEXINGTON — BOARD OF PUBLIC WORKS  
SEWER DIVISION

Sketch of Service Here

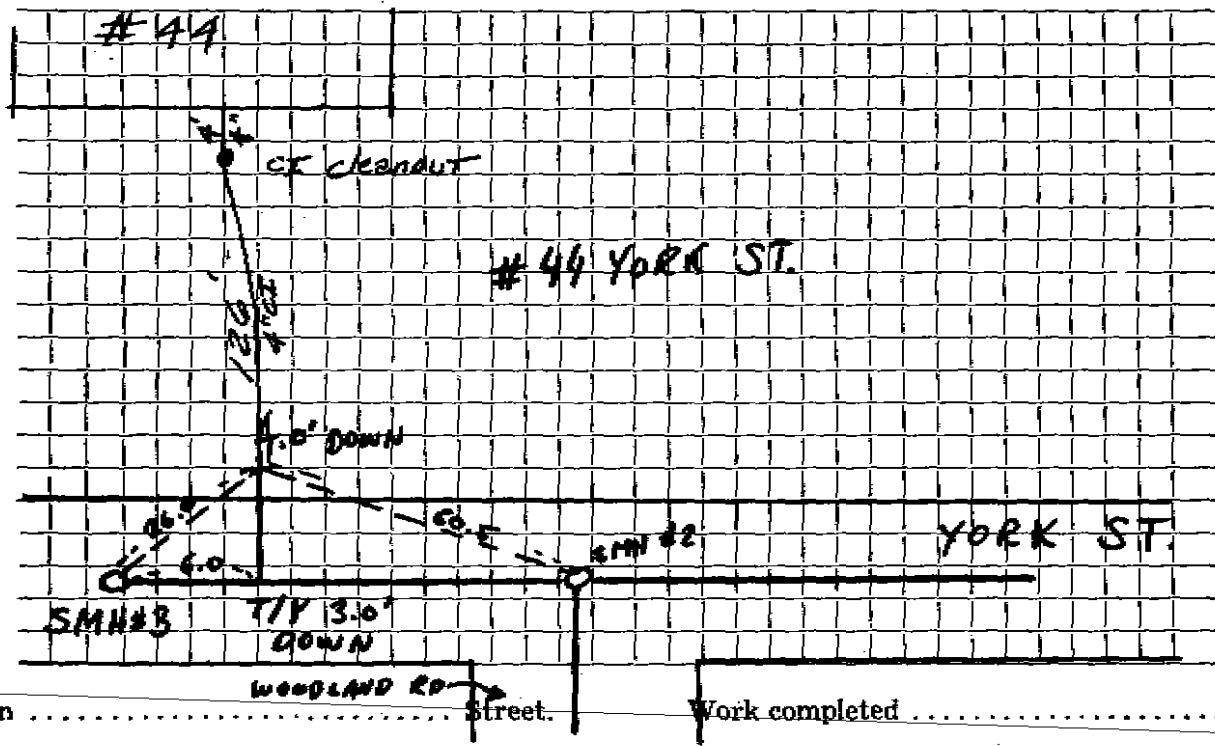

Connection made in ..... Street. Work completed .....

Remarks: .....  
.....  
.....