

Name Robert Canfield

Service No. 157

Address 51 YORK ST

Location

Kind of Pipe A.C.

Size 6"

Size of Main 8"

Repair—Renewal—New Service *Trabino Const. # 2430*


Location APR 8 1974

Date	Material	Amount	Total	Date	Amount	
8/10/73	240'-6" A.C.P. @ \$9.00	\$ 216.00		11-5-73	Deposit	216.00
11-15-73	72'-0" ACP					
	7'-4" CI					

DATE _____

TOWN OF LEXINGTON — BOARD OF PUBLIC WORKS
SEWER DIVISION

Sketch of Service Here

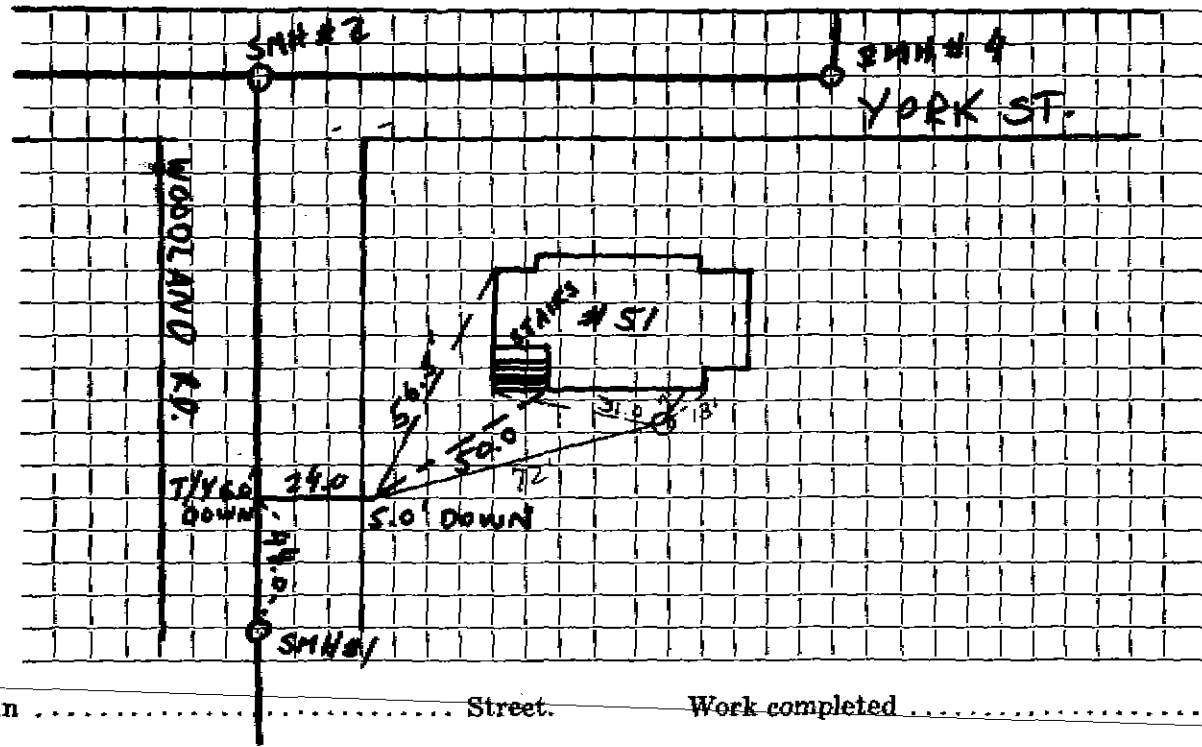

Connection made in Street. Work completed

Remarks:
.....
.....