

Name Carole D. Daniels

Service No. 10

Address 11 Young St.

Location

Kind of Pipe ACP

Size 6"

Size of Main 8"

~~REPERCUSSION~~ New Service J. Redmond #3963


Location JUN 23 1980

Date	Material	Amount	Total	Date	Amount
8-15 73	21' @ \$9.00	\$ 189.00		4-22-80	189.00
6-23-80	31' 6" Transite pipe				
	10' 4" Cast iron pipe				

DATE \_\_\_\_\_

TOWN OF LEXINGTON — BOARD OF PUBLIC WORKS  
SEWER DIVISION

Sketch of Service Here

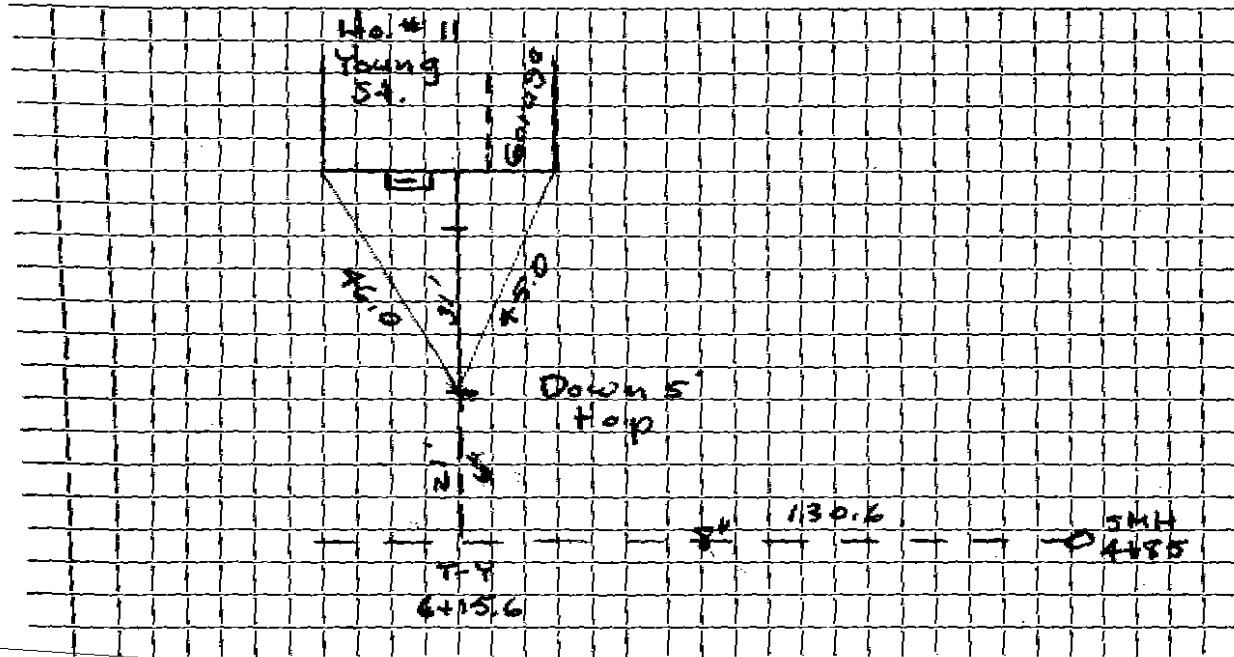

Connection made in Young St. Street. Work completed \_\_\_\_\_

Remarks: \_\_\_\_\_  
\_\_\_\_\_  
\_\_\_\_\_